

MISSISSIPPI DEPARTMENT OF NATURAL RESOURCES

Bureau of Land and Water Resources

Southport Mall

P.O. Box 10631

Jackson, Mississippi 39209

WATER WELL DRILLERS LOG

Hancock
Kr 2589
5-14-85

L

5-14-1985 date well completed 85 Ward Well Drg. firm name Hancock county well located

LANDOWNER: Frank Meloch
Pensetta St.
Clermont Harbor, ms.
 (mailing address)

description of formations encountered	from	to
<u>fill-clay</u>	<u>0</u>	<u>12</u>
<u>clay</u>	<u>12</u>	<u>18</u>
<u>sd</u>	<u>18</u>	<u>44</u>
<u>clay</u>	<u>44</u>	<u>105</u>
<u>sd - blue gravel</u>	<u>105</u>	<u>120</u>
<u>clay - silt</u>	<u>120</u>	<u>276</u>
<u>coke sd</u>	<u>276</u>	<u>315</u>

WELL LOCATION:
 sec. 17 T. 9 N. R. 14 E.
 (distance) miles (direction) of Clermont Harbor (nearest town)

WELL PURPOSE: Home
 (home, irrigation, municipal, industrial)

WELL COMPLETION DATA:

(1) diameter (inches) 2"

(2) total depth (feet) 315

(3) static water level (feet) 8 below top of ground.

(4) casing PVC, 305' (material), (depth)
 (size) if telescope see back.

(5) screen 10' (length), (depth to top)
2" (size), PVC (material)

(6) pump owner (HP), (yield gpm)
 (type power)

(7) electric log NO (yes or no)
N/A (organization running log)


(8) how well bottom plugged BWU

RECEIVED
 JUL 12 1985

DRILLERS REMARKS: N/A

If well telescopes please sketch and show depths.

GROUND LEVEL

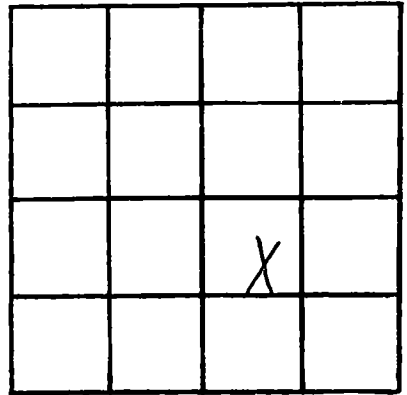

SECTION 17

Please indicate well location X.

ADDITIONAL INFORMATION

If more than one screen, show locations of each on sketch.