

MISSISSIPPI DEPARTMENT OF NATURAL RESOURCES

Bureau of Land and Water Resources

Southport Mall

P.O. Box 10631

Jackson, Mississippi 39209

WATER WELL DRILLERS LOG

Hancock
K 2590
5-15-85

L

5-15- date well completed 1985 Ward Well Dly. firm name Hancock county well located

LANDOWNER: John D. Canuth
Hogon St.
Waveland, ms.
(mailing address)

description of formations encountered	from	to
	Top Soil - clay	0
sd	15	38
clay	38	98
sd	98	110
clay - silt	110	165
sd - sea - gravel	165	185

WELL LOCATION:
sec. 34 T. 8 N. R. 13 E. S. 14
miles (distance) of Waveland (direction) (nearest town)

WELL PURPOSE: Home
(home, irrigation, municipal, industrial)

WELL COMPLETION DATA:

(1) diameter (inches) 2"

(2) total depth (feet) 185

(3) static water level (feet) 17 below top of ground.

(4) casing PVC, 175 (material), (depth)

(size) If telescope see back.

(5) screen 10' (length), (depth to top)

2" PVC (size), (material)

(6) pump crown (HP), (yield gpm)

(type power)

(7) electric log NO (yes or no)

N/A (organization running log)


(8) how well bottom plugged BWD

RECEIVED
JUL 12 1985

DRILLERS REMARKS: N/A

If well telescopes please sketch and show depths.

GROUND LEVEL

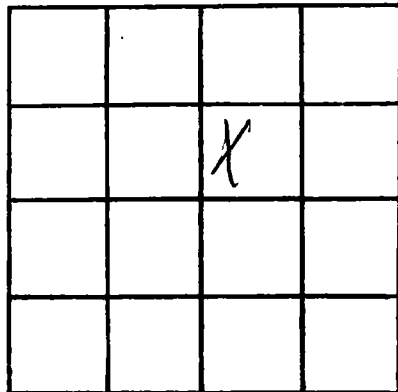

SECTION 34

Please indicate well location X.

ADDITIONAL INFORMATION

If more than one screen, show locations of each on sketch.