

MISSISSIPPI DEPARTMENT OF NATURAL RESOURCES

Bureau of Land and Water Resources

Southport Mall

P.O. Box 10631

Jackson, Mississippi 39209

WATER WELL DRILLERS LOG

HANCOCK
K 2591

June 5 1985 date well completed Ward Well Dlg. firm name Hancock county well located

LANDOWNER: Francis Keith
110 Santiago Rd.
Waveland ms.
(mailing address)

description of formations encountered	from	to
	Sandy Soil	0
Clay	5	12
sd	12	38
Clay-Silt	38	104
sd	104	132
Clay	132	146
sd - Red Gravel		

WELL LOCATION:
sec. 33 T. 8 N. R. 13 E. 14
1 miles N Waveland
(distance) (direction) of (nearest town)

WELL PURPOSE: None
(home, irrigation, municipal, industrial)

WELL COMPLETION DATA:

(1) diameter (inches) 2"

(2) total depth (feet) 168

(3) static water level (feet) 12 below top of ground.

(4) casing PVC 158 (material) (depth)

(size) If telescope see back.

(5) screen 10' (length) (depth to top)

2" PVC (size) (material)

(6) pump runs (HP) (yield gpm)

(type power)

(7) electric log NO (yes or no)

N/A (organization running log)

(8) how well bottom plugged BWV


RECEIVED
AUG 20 1985

DRILLERS REMARKS: Si

Department of Natural Resources
Bureau of Land & Water Resources

If well telescopes please sketch and show depths.

GROUND LEVEL

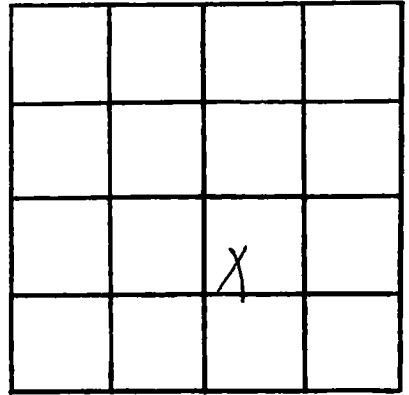

SECTION 33

Please indicate well location X.

ADDITIONAL INFORMATION

If more than one screen,
show locations of each on sketch.