

MISSISSIPPI DEPARTMENT OF NATURAL RESOURCES

Bureau of Land and Water Resources

Southport Mall

P.O. Box 10631

Jackson, Mississippi 39209

WATER WELL DRILLERS LOG

HANCOCK
K 2592

June 7 1985 date well completed
Ward Well Dlg. firm name
Hancock county well located

LANDOWNER: William Stewart
Dolphin St.
Bay St. Louis Mrs.
(mailing address)

description of formations encountered	from	to
	fill - clay	0
sd	16	45
clay - silt	45	95
fine sd	95	116
clay - silt	116	155
sd	155	176

WELL LOCATION:
sec. 28 T 8 N R 13 E 14
7 miles N/W of B.S.L.
(distance) (direction) (nearest town)

WELL PURPOSE: Home
(home, irrigation, municipal, industrial)

- WELL COMPLETION DATA:
- (1) diameter (inches) 2"
 - (2) total depth (feet) 176
 - (3) static water level (feet) 8 ^{below} _{above} top of ground.
 - (4) casing PVC, 166,
(material) (depth)
(size) if telescope see back.
 - (5) screen 10',
(length) (depth to top)
2", PVC
(size) (material)
 - (6) pump owner,
(HP) (yield gpm)
(type power)
 - (7) electric log no
(yes or no)
N/A
(organization running log)
 - (8) how well bottom plugged BWU


RECEIVED
AUG 20 1985

Department of Natural Resources
Bureau of Land & Water Resources

DRILLERS REMARKS: N/A

If well telescopes please sketch and show depths.

GROUND LEVEL

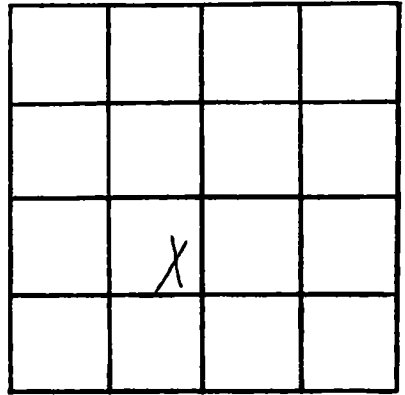

SECTION 28

Please indicate well location X.

ADDITIONAL INFORMATION

If more than one screen, show locations of each on sketch.