

MISSISSIPPI DEPARTMENT OF NATURAL RESOURCES

Bureau of Land and Water Resources

Southport Mall

P.O. Box 10631

Jackson, Mississippi 39209

WATER WELL DRILLERS LOG

HANCOCK
K 2595

June 7 1985 date well completed
85 Ward Well Drg. firm name
Hancock county well located

LANDOWNER: S.W. Cathoun
Evelyn Place
Clearmont Harbor ms.
(mailing address)

WELL LOCATION:
sec. 17 T 9 N R 14 E
(distance) miles (direction) of Clearmont (nearest town)

WELL PURPOSE: None
(home, irrigation, municipal, industrial)

WELL COMPLETION DATA:
(1) diameter (inches) 2"
(2) total depth (feet) 310
(3) static water level (feet) 10 below top of ground.
(4) casing 2" (material), 300 (depth).
(size) If telescope see back.
(5) screen 10' (length), (depth to top) 2" (size), PVC (material)
(6) pump Ornes (HP), (yield gpm)
(type power)
(7) electric log No (yes or no)
(organization running log) N/A
(8) how well bottom plugged BWV

description of formations encountered	from	to
Top Soil - clay	0	12
SD	12	46
clay	46	105
Red Shale - SD	105	128
clay - silt	128	275
Coar SD	275	310


DRILLERS REMARKS: N/A

RECEIVED
AUG 20 1985

Department of Natural Resources
Bureau of Land & Water Resources

If well telescopes please sketch and show depths.

GROUND LEVEL

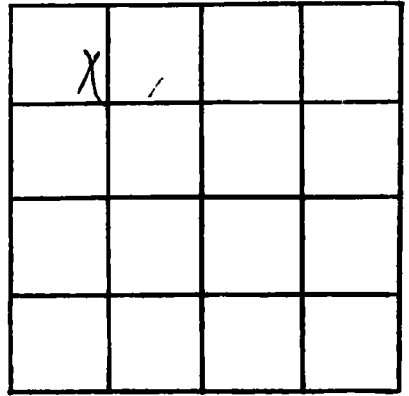

SECTION 17

Please indicate well location X.

ADDITIONAL INFORMATION

If more than one screen,
show locations of each on sketch.