

MISSISSIPPI DEPARTMENT OF NATURAL RESOURCES

Bureau of Land and Water Resources

Southport Mall

P.O. Box 10631

Jackson, Mississippi 39209

WATER WELL DRILLERS LOG

HANCOCK

K 2398

June 25

1985 Ward Well Drg.

Hancock

date well completed

firm name

county well located

LANDOWNER: Joyce Maltz

Eric + Dee St.

Bay St. Louis, ms.
(mailing address)

WELL LOCATION:

sec. 26 T 8 N R 12 E
4 miles N/W of B.S.L.
(distance) (direction) (nearest town)

WELL PURPOSE: Home
(home, irrigation, municipal, industrial)

WELL COMPLETION DATA:

- (1) diameter (inches) 2"
- (2) total depth (feet) 330
- (3) static water level (feet) 1 below top of ground.
- (4) casing PVC, 320 (material) (depth)
- (size) If telescope see back.
- (5) screen 10' (length) (depth to top)
- 2" PVC (size) (material)
- (6) pump none (HP) (yield gpm)
- (type power)
- (7) electric log NO (yes or no)
- N/A (organization running log)
- (8) how well bottom plugged BWW

description of formations encountered

from

to


Clay	0	18
sd	18	42
Clay-silt	42	98
Fine sd	98	115
Clay-silt	115	148
Fine sd	148	162
Clay-silt	162	284
Coarse sd	284	330

DRILLERS REMARKS: N/A

RECEIVED
AUG 20 1985

If well telescopes please sketch and show depths.

GROUND LEVEL

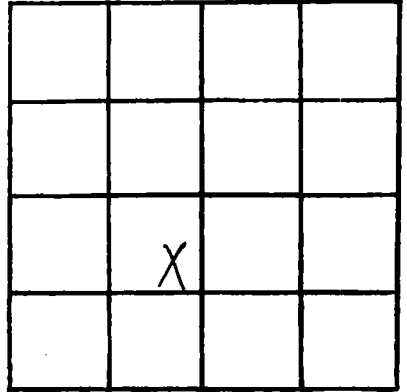

SECTION 26

Please indicate well location X.

ADDITIONAL INFORMATION

If more than one screen,
show locations of each on sketch.