

MISSISSIPPI DEPARTMENT OF NATURAL RESOURCES

Bureau of Land and Water Resources

Southport Mall

P.O. Box 10631

Jackson, Mississippi 39209

WATER WELL DRILLERS LOG

HANCOCK
K 2599

June 28 1985 Ward Well Drilling Hancock
date well completed firm name county well located

LANDOWNER: Henry Wallis
Dun St.
Bay St. Loring, ms.
(mailing address)

WELL LOCATION:
sec. 26 T. 8 N R. 13 E 14
5 miles N/W of B.S. L.
(distance) (direction) (nearest town)

WELL PURPOSE: Farm
(home, irrigation, municipal, industrial)

WELL COMPLETION DATA:
(1) diameter (inches) 2"
(2) total depth (feet) 415'
(3) static water level (feet) 1 below top of ground.
(4) casing PVC 405' (material) (depth)
(size) If telescope see back.
(5) screen 10' (length) (depth to top)
2" PVC (size) (material)
(6) pump none (HP) (yield gpm)
(type power)
(7) electric log NO (yes or no)
N/A (organization running log)
(8) how well bottom plugged BWB

description of formations encountered	from	to
clay	0	15
sd	15	47
clay	47	94
fine sd	94	110
clay-silt	110	152
fine sd	152	165
clay-silt	165	270
fine sd	270	304
clay-silt	304	376
coar sd	376	415


DRILLERS REMARKS: N/A

RECEIVED
AUG 20 1985

Department of Natural Resources
Bureau of Land and Water Resources

If well telescopes please sketch and show depths.

GROUND LEVEL

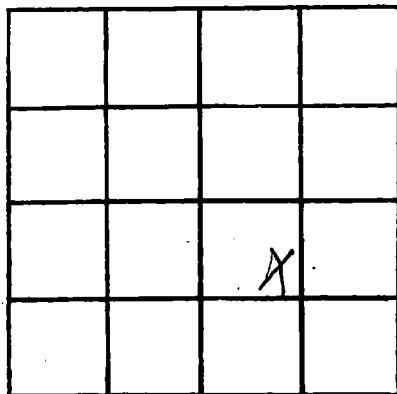

SECTION 26

Please indicate well location X.

ADDITIONAL INFORMATION

If more than one screen, show locations of each on sketch.