

**MISSISSIPPI DEPARTMENT OF NATURAL RESOURCES**  
**Bureau of Land and Water Resources**  
 Southport Mall  
 P.O. Box 10631  
 Jackson, Mississippi 39209  
**WATER WELL DRILLERS LOG**

K 2601  
Hancock  
7-9-85

July 9 19 85 Ward Well Drg. Hancock  
 date well completed firm name county well located

**LANDOWNER:** Billie Powell  
Rt. 4, Box 364  
Bay St. Louis, ms.  
 (mailing address)

**WELL LOCATION:**  
 sec. 26 T 8 N R 12 E 16P  
4 miles N/W of R.S.L.  
 (distance) (direction) (nearest town)

**WELL PURPOSE:** Home  
 (home, irrigation, municipal, industrial)

**WELL COMPLETION DATA:**

- (1) diameter (inches) 2"
- (2) total depth (feet) 310'
- (3) static water level (feet) 1 below above  
 top of ground.
- (4) casing PVC, 300,  
 (material) (depth)  
         If telescope see back.  
 (size)
- (5) screen 10',           
 (length) (depth to top)  
2", PVC  
 (size) (material)
- (6) pump owner           
 (HP) (yield gpm)  
          
 (type power)
- (7) electric log no  
 (yes or no)  
N/A  
 (organization running log)
- (8) how well bottom plugged BWU

description of formations encountered	from	to
	<u>fill - clay</u>	<u>0</u>
<u>sd</u>	<u>17</u>	<u>46</u>
<u>clay</u>	<u>46</u>	<u>142</u>
<u>fine sd</u>	<u>142</u>	<u>165</u>
<u>clay - silt</u>	<u>165</u>	<u>276</u>
<u>sd</u>	<u>276</u>	<u>310</u>


**DRILLERS REMARKS:** N/A

**RECEIVED**  
 SEP 26 1985

Department of Natural Resources  
 Bureau of Land & Water Resources

If well telescopes please sketch and show depths.

GROUND LEVEL

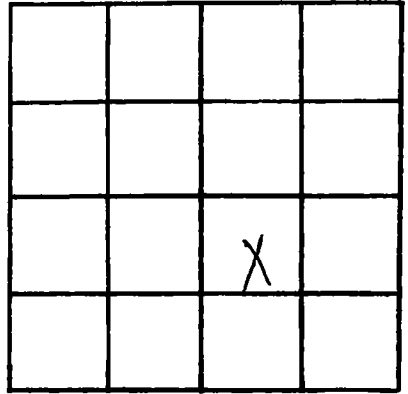

SECTION 26

Please indicate well location X.

ADDITIONAL INFORMATION

If more than one screen,  
show locations of each on sketch.