

MISSISSIPPI DEPARTMENT OF NATURAL RESOURCES

Bureau of Land and Water Resources

Southport Mall

P.O. Box 10631

Jackson, Mississippi 39209

WATER WELL DRILLERS LOG

K 2603
Hancock
7-17-85

July 17 1985 Ward Well Drg. Hancock
date well completed firm name county well located

LANDOWNER: D. D. Dinkue
South Carolina St.
Bay St. Louis, Miss
(mailing address)

description of formations encountered	from	to
fill - clay	0	16
SS	16	47
clay - silt	47	105
fine silt	105	121
clay - silt	121	137
SS	137	160

WELL LOCATION:
sec. 28 T. 8 N R. 17 E 4
5 miles N/W of B.S.L.
(distance) (direction) (nearest town)

WELL PURPOSE: Home
(home, irrigation, municipal, industrial)

- WELL COMPLETION DATA:
- (1) diameter (inches) 2"
 - (2) total depth (feet) 160
 - (3) static water level (feet) 8 (below top of ground)
 - (4) casing PVC, 150 (material) (depth)
If telescope see back. (size)
 - (5) screen 10' (length) (depth to top)
2" (size) PVC (material)
 - (6) pump owner (HP) (yield gpm)
(type power)
 - (7) electric log NO (yes or no)
N/A (organization running log)
 - (8) how well bottom plugged BUW


RECEIVED
SEP 26 1985

DRILLERS REMARKS: N/A

Department of Natural Resources
Bureau of Land & Water Resources

If well telescopes please sketch and show depths.

GROUND LEVEL

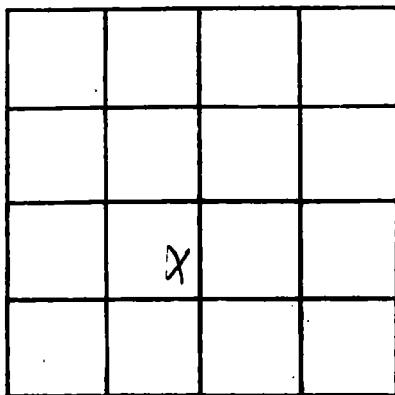

SECTION 28

Please indicate well location X.

ADDITIONAL INFORMATION

If more than one screen, show locations of each on sketch.