

MISSISSIPPI DEPARTMENT OF NATURAL RESOURCES

Bureau of Land and Water Resources

Southport Mall

P.O. Box 10631

Jackson, Mississippi 39209

WATER WELL DRILLERS LOG

K 2606
Hannock

July 25 1985 Ward Well Dr. Hannock
date well completed firm name county well located

LANDOWNER Mary P. Cusly
Sale St.
Bay St. Levin, ms.
(mailing address)

WELL LOCATION:
sec. 37 T 8 N R 13 E 14 W
miles N/W of B.S.L.
(distance) (direction) (nearest town)

WELL PURPOSE: Home
(home, irrigation, municipal, industrial)

WELL COMPLETION DATA:

(1) diameter (inches) 2"

(2) total depth (feet) 550'

(3) static water level (feet) 5 below above
top of ground.

(4) casing PVC, 530,
(material) (depth)
- If telescope see back.
(size)

(5) screen 20', -
(length) (depth to top)
2", PVC
(size) (material)

(6) pump 1/2, 10
(HP) (yield gpm)
Elec.
(type power)

(7) electric log NO
(yes or no)
N/A
(organization running log)

(8) how well bottom plugged BWD

description of formations encountered	from	to
Clay	0	16
Clay sd	16	51
Clay	51	90
fine sd	90	115
Clay - Silt	115	152
sd	152	170
Clay - Silt	170	376
sd	376	420
Clay - Silt	420	505
Coar sd	505	550


RECEIVED
SEP 26 1985

DRILLERS REMARKS: N/A

Department of Natural Resources
Bureau of Land & Water Resources

If well telescopes please sketch and show depths.

GROUND LEVEL

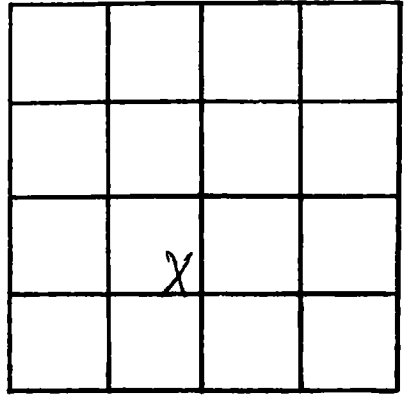

SECTION 37

Please indicate well location X.

ADDITIONAL INFORMATION

If more than one screen,
show locations of each on sketch.