

MISSISSIPPI DEPARTMENT OF NATURAL RESOURCES
Bureau of Land and Water Resources
 Southport Mall
 P.O. Box 10631
 Jackson, Mississippi 39209
WATER WELL DRILLERS LOG

K 2608
Hancock
8-1-85

Aug. 1 1985 Wood Well Dlg. Hancock
 date well completed firm name county well located

LANDOWNER: John Greer
14th St.
Bay St. Louis, ms.
 (mailing address)

WELL LOCATION:
 sec. 28 T-8 N R-13 E
5 miles NW of Bay St. Louis
 (distance) (direction) (nearest town)

WELL PURPOSE: None
 (home, irrigation, municipal, industrial)

WELL COMPLETION DATA:

(1) diameter (inches) 2"

(2) total depth (feet) 168

(3) static water level (feet) 10 below above top of ground.

(4) casing PVC, 158,
 (material) (depth)
 (size) if telescope see back.

(5) screen 10', -
 (length) (depth to top)
2", PVC
 (size) (material)

(6) pump none, -
 (HP) (yield gpm)
 (type power)

(7) electric log NO
 (yes or no)
N/A
 (organization running log)

(8) how well bottom plugged BWV

description of formations encountered	from to	
	feet	feet
<u>Clay</u>	<u>0</u>	<u>11</u>
<u>SS</u>	<u>11</u>	<u>38</u>
<u>Clay - Silt</u>	<u>38</u>	<u>95</u>
<u>Flne Sl</u>	<u>95</u>	<u>114</u>
<u>Clay - Silt</u>	<u>114</u>	<u>153</u>
<u>SS</u>	<u>153</u>	<u>168</u>


RECEIVED
 SEP 26 1985

DRILLERS REMARKS: N/A

Department of Natural Resources
 Bureau of Land and Water Resources

If well telescopes please sketch and show depths.

GROUND LEVEL

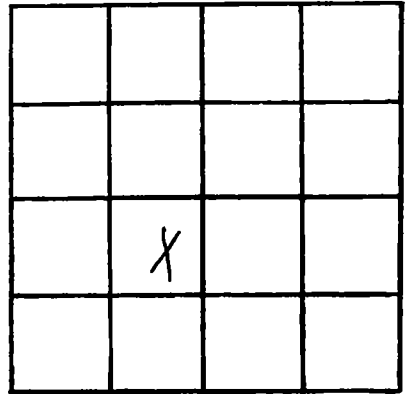

SECTION 28

Please indicate well location X.

ADDITIONAL INFORMATION

Lined area for additional information.

If more than one screen, show locations of each on sketch.