

MISSISSIPPI DEPARTMENT OF NATURAL RESOURCES

Bureau of Land and Water Resources

Southport Mall

P.O. Box 10631

Jackson, Mississippi 39209

WATER WELL DRILLERS LOG

HANCOCK
K2609

8-1

1985

McNeil Pump & Well

Harrison 17 Hancock

date well completed

firm name

county well located

LANDOWNER

Spencer & Thoreson Const.

description of formations encountered

from

to

525 De Montigny Ave

Bay St. Louis, Ms. 39520
(mailing address)

Sand

0 60

Mud/Sand

60 80

Mud

80 140

Mud/Sand

140 160

Sand

160 200

WELL LOCATION:

sec. 19 T 9 N R 17 E 13
4 miles N of Bay St. Louis
(distance) (direction) (nearest town)

WELL PURPOSE:

(home, irrigation, municipal, industrial)

WELL COMPLETION DATA:

- (1) diameter (inches) 2'
- (2) total depth (feet) 200
- (3) static water level (feet) 2' (below) above top of ground.
- (4) casing Sch. 40 PVC, 190' (material) (depth)
(size) If telescope see back.
- (5) screen 10' 190' (length) (depth to top)
2" Sch 80-6 slot PVC (size) (material)
- (6) pump N/A (MP) (yield gpm)
(type power)
- (7) electric log (yes or no)
(organization running log)
- (8) how well bottom plugged Sand
Duck


DRILLERS REMARKS:

RECEIVED
AUG 20 1985

Department of Natural Resources
Bureau of Land & Water Resources

If well telescopes please sketch and show depths.

GROUND LEVEL

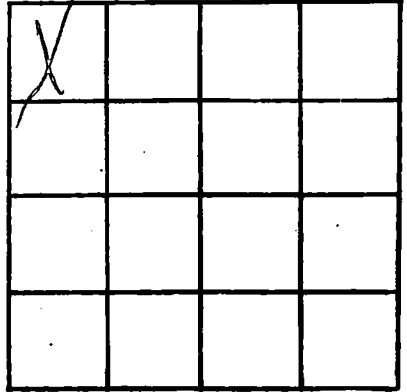

SECTION _____

Please indicate well location X.

ADDITIONAL INFORMATION

If more than one screen, show locations of each on sketch.