

MISSISSIPPI DEPARTMENT OF NATURAL RESOURCES

Bureau of Land and Water Resources

Southport Mall

P.O. Box 10631

Jackson, Mississippi 39209

WATER WELL DRILLERS LOG

Handcock
K 2610

Aug. 5 1985 Ward Well Drg Hancock
 date well completed firm name county well located

LANDOWNER: John H. Dufuy
 Bayou Sacroix Est.
 Bay St. Louis, Mo.
 (mailing address)

description of formations encountered	from	to
fill - clay	0	12
sd	12	35
clay	35	54
kaol shale - sd	54	67
clay - silt	67	95
coral sd	95	120

WELL LOCATION:
 sec. 40 T. 8 N R. 13 E
 8 1/2 miles N/W of B.S.L.
 (distance) (direction) (nearest town)

WELL PURPOSE: Home
 (home, irrigation, municipal, industrial)

- WELL COMPLETION DATA:
- (1) diameter (inches) 2"
 - (2) total depth (feet) 120
 - (3) static water level (feet) 2 ^{below} _{above} top of ground.
 - (4) casing PVC, 110,
 (material) (depth)
 (size) if telescope see back.
 - (5) screen 10',
 (length) (depth to top)
2", PVC
 (size) (material)
 - (6) pump over,
 (HP) (yield gpm)
 (type power)
 - (7) electric log N/A
 (yes or no)
N/A
 (organization running log)
 - (8) how well bottom plugged BWV


DRILLERS REMARKS: N/A

RECEIVED
 NOV - 1 1985

Department of Natural Resources
 Bureau of Land & Water Resources

If well telescopes please sketch and show depths.

GROUND LEVEL

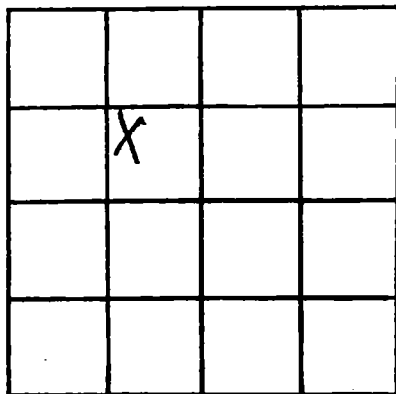

SECTION 40

Please indicate well location X.

ADDITIONAL INFORMATION

If more than one screen, show locations of each on sketch.