

MISSISSIPPI DEPARTMENT OF NATURAL RESOURCES

Bureau of Land and Water Resources

Southport Mall

P.O. Box 10631

Jackson, Mississippi 39209

WATER WELL DRILLERS LOG

HANCOCK
K 2611

Aug. 5 1985 Ward Well Dlg Hancock
 date well completed firm name county well located

LANDOWNER: Henry J. Brenels
 Bayou LaCoux Est.
 Bay St. Louis, ms.
 (mailing address)

description of formations encountered	from	to
Clay-Silt	0	12
Sd	12	31
Clay	31	56
Red Gravel - Sd	56	72
Clay	72	94
Clay Sd	94	120

WELL LOCATION:
 sec. 4 D T 8 N R 13 E
 8 miles N/W of B.S.L.
 (distance) (direction) (nearest town)

WELL PURPOSE: Home
 (home, irrigation, municipal, industrial)

- WELL COMPLETION DATA:
- (1) diameter (inches) 2"
 - (2) total depth (feet) 120
 - (3) static water level (feet) 4 below top of ground.
 - (4) casing PVC 110 (material) (depth)
 If telescope see back.
 - (5) screen 10' (length) (depth to top)
 2" PVC (size) (material)
 - (6) pump none (HP) (yield gpm)
 (type power)
 - (7) electric log NO (yes or no)
 N/A (organization running log)
 - (8) how well bottom plugged BWU


RECEIVED
 NOV -1 1985

DRILLERS REMARKS: N/A

Department of Natural Resources
 Bureau of Land & Water Resources

If well telescopes please sketch and show depths.

GROUND LEVEL

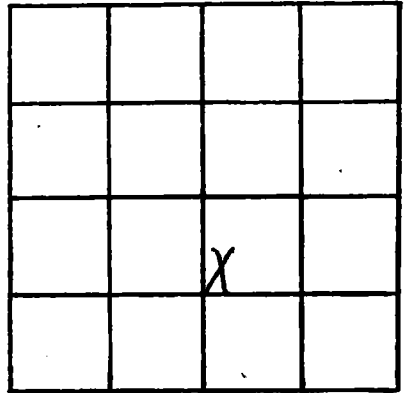

SECTION 40

Please indicate well location X.

ADDITIONAL INFORMATION

If more than one screen,
show locations of each on sketch.