

MISSISSIPPI DEPARTMENT OF NATURAL RESOURCES

Bureau of Land and Water Resources

Southport Mall

P.O. Box 10631

Jackson, Mississippi 39209

WATER WELL DRILLERS LOG

Hancock  
K 2612

Aug. 7 1985 Ward Well Dr. Hancock  
date well completed firm name county well located

LANDOWNER B. J. Casson  
Larson Drive  
Bay St. Louis, Ms.  
(mailing address)

WELL LOCATION:  
sec. 22 T. 8 N R. 13<sup>14</sup> E  
5 miles N/W of B.S.L.  
(distance) (direction) (nearest town)

WELL PURPOSE: Home  
(home, irrigation, municipal, industrial)

- WELL COMPLETION DATA:
- (1) diameter (inches) 2"
  - (2) total depth (feet) 170
  - (3) static water level (feet) 8 <sup>below</sup> <sub>above</sub> top of ground.
  - (4) casing PVC, 160  
(material) (depth)  
- if telescope see back.  
(size)
  - (5) screen 10' -  
(length) (depth to top)  
2" PVC  
(size) (material)
  - (6) pump over -  
(HP) (yield gpm)  
(type power)
  - (7) electric log NO  
(yes or no)  
N/A  
(organization running log)
  - (8) how well bottom plugged BWU

DRILLERS REMARKS: N/A

description of formations encountered	from	to
<u>clay</u>	<u>0</u>	<u>18</u>
<u>clay sd</u>	<u>18</u>	<u>42</u>
<u>clay</u>	<u>42</u>	<u>96</u>
<u>fine slt</u>	<u>96</u>	<u>115</u>
<u>clay-silt</u>	<u>115</u>	<u>152</u>
<u>sd</u>	<u>152</u>	<u>170</u>


**RECEIVED**

NOV -1 1985

Department of Natural Resources  
Bureau of Land & Water Resources

If well telescopes please sketch and show depths.

GROUND LEVEL

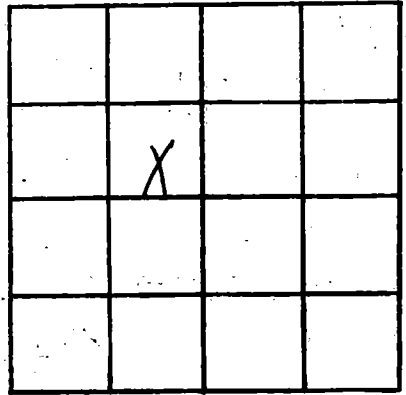

SECTION 22

Please indicate well location X.

ADDITIONAL INFORMATION

If more than one screen, show locations of each on sketch.