

MISSISSIPPI DEPARTMENT OF NATURAL RESOURCES

Bureau of Land and Water Resources

Southport Mall

P.O. Box 10631

Jackson, Mississippi 39209

WATER WELL DRILLERS LOG

Hancock
K 2613

Aug. 9 1985 Wood Well Dr. Hancock
date well completed firm name county well located

LANDOWNER: Elenora J. Sogard
Lazy River Est.
Box St. Louis, Mo.
(mailing address)

description of formations encountered	from	to
<u>clay</u>	<u>0</u>	<u>15</u>
<u>sd</u>	<u>15</u>	<u>45</u>
<u>clay - silt</u>	<u>45</u>	<u>98</u>
<u>fine sd</u>	<u>98</u>	<u>116</u>
<u>clay</u>	<u>116</u>	<u>122</u>
<u>sd</u>	<u>122</u>	<u>140</u>

WELL LOCATION:
sec. 28 T. 8 N R. 13 E
5 miles N/W of B.S.S.
(distance) (direction) (nearest town)

WELL PURPOSE: Home
(home, irrigation, municipal, industrial)

WELL COMPLETION DATA:

(1) diameter (inches) 2"

(2) total depth (feet) 140'

(3) static water level (feet) 8 below above
top of ground.

(4) casing PVC 130
(material) (depth)
- if telescope see back.
(size)

(5) screen 10' -
(length) (depth to top)
2" PVC
(size) (material)

(6) pump owner -
(HP) (yield gpm)
-
(type power)

(7) electric log no
(yes or no)
N/A
(organization running log)

(8) how well bottom plugged BW


RECEIVED

NOV - 1 1985

DRILLERS REMARKS: N/A

If well telescopes please sketch and show depths.

GROUND LEVEL

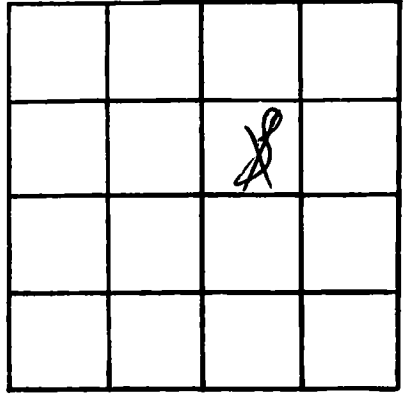

SECTION 28

Please indicate well location X.

ADDITIONAL INFORMATION

If more than one screen, show locations of each on sketch.