

MISSISSIPPI DEPARTMENT OF NATURAL RESOURCES

Bureau of Land and Water Resources

Southport Mall

P.O. Box 10631

Jackson, Mississippi 39209

WATER WELL DRILLERS LOG

Hancock
K 2616

Aug. 20 19 85 Wood Well Drg. Hancock
 date well completed firm name county well located

LANDOWNER: Edward J. Hiken
 Elburn - Sat 6
 Bay St. Louis, ms.
 (mailing address)

description of formations encountered	from	to
fill - clay	0	21
sd	21	47
clay - silt	47	106
fine sd	106	122
clay - silt	122	185
coal sd	185	210

WELL LOCATION:
 sec. 40 T. 8 N R. 13 E
 10 miles N/W of B.S.L.
 (distance) (direction) (nearest town)

WELL PURPOSE: Home
 (home, irrigation, municipal, industrial)

- WELL COMPLETION DATA:
- (1) diameter (inches) 2"
 - (2) total depth (feet) 210
 - (3) static water level (feet) 2 ^{below} top of ground.
 - (4) casing PVC, 200.
 (material) (depth)
 - if telescope see back.
 (size)
 - (5) screen 10, -
 (length) (depth to top)
 2", PVC
 (size) (material)
 - (6) pump none -
 (HP) (yield gpm)
 -
 (type power)
 - (7) electric log NO
 (yes or no)
 N/A
 (organization running log)
 - (8) how well bottom plugged BW


RECEIVED
 NOV - 1 1985

DRILLERS REMARKS: N/A

Department of Natural Resources
 Bureau of Land & Water Resources

If well telescopes please sketch and show depths.

GROUND LEVEL

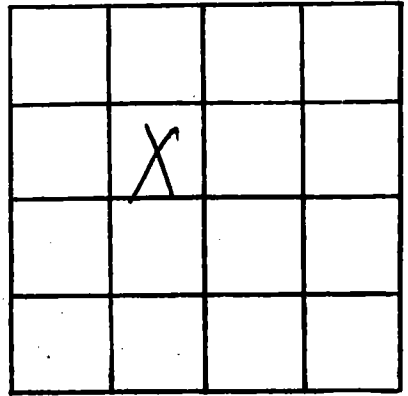

SECTION _____

Please indicate well location X.

ADDITIONAL INFORMATION

If more than one screen, show locations of each on sketch.