

MISSISSIPPI DEPARTMENT OF NATURAL RESOURCES

Bureau of Land and Water Resources

Southport Mall

P.O. Box 10631

Jackson, Mississippi 39209

WATER WELL DRILLERS LOG

Hancock  
K 2619

Oct. 16  
date well completed

1985 Ward Well Drg.  
firm name

Hancock  
county well located

LANDOWNER: Harold P. DeLoade  
1336 Elizabeth Blvd.  
Bay St. Louis, Miss.  
(mailing/address)

description of formations encountered	from	to
<u>clay</u>	<u>0</u>	<u>24</u>
<u>clay sl</u>	<u>24</u>	<u>35</u>
<u>clay-silt</u>	<u>35</u>	<u>96</u>
<u>sl</u>	<u>96</u>	<u>105</u>
<u>clay-silt</u>	<u>105</u>	<u>198</u>
<u>lode sl</u>	<u>198</u>	<u>229</u>

WELL LOCATION:  
sec. 40 T. 8 N. R. 13<sup>14</sup> E  
7 miles N/W of Warland  
(distance) (direction) (nearest town)

WELL PURPOSE: none  
(home, irrigation, municipal, industrial)

- WELL COMPLETION DATA:
- (1) diameter (inches) 2"
  - (2) total depth (feet) 229'
  - (3) static water level (feet) 2 <sup>below</sup> above top of ground.
  - (4) casing PVC 219'  
(material) (depth)  
- If telescope see back.  
(size)
  - (5) screen 10' -  
(length) (depth to top)  
2" PVC  
(size) (material)
  - (6) pump Quincy -  
(HP) (yield gpm)  
-  
(type power)
  - (7) electric log NO  
(yes or no)  
-  
(organization running log)
  - (8) how well bottom plugged BWU


DRILLERS REMARKS: N/A

**RECEIVED**

NOV 20 1985

If well telescopes please sketch and show depths.

GROUND LEVEL

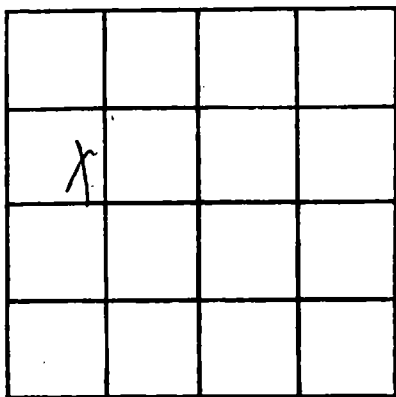

SECTION 40

Please indicate well location X.

ADDITIONAL INFORMATION

If more than one screen,  
show locations of each on sketch.