

MISSISSIPPI DEPARTMENT OF NATURAL RESOURCES

Bureau of Land and Water Resources

Southport Mall

P.O. Box 10631

Jackson, Mississippi 39209

WATER WELL DRILLERS LOG

Hancock
K 2620

10-22
date well completed

1985 Ward Well Dly.
firm name

Hancock
county well located

LANDOWNER: Herald B. Jergin Jr.
Rt. 4, Box 152
Bay St. Louis, Miss.
(mailing address)

WELL LOCATION:
sec. 37 T. 8 N. R. 13 E. S. 14
4 miles N/W of B.S.L.
(distance) (direction) (nearest town)

WELL PURPOSE: Home
(home, irrigation, municipal, industrial)

WELL COMPLETION DATA:

- (1) diameter (inches) 2"
- (2) total depth (feet) 546
- (3) static water level (feet) 5 below top of ground.
- (4) casing PVC, 526,
(material) (depth)
— If telescope see back.
(size)
- (5) screen 20', —
(length) (depth to top)
2", PVC
(size) (material)
- (6) pump owner, —
(HP) (yield gpm)
— (type power)
- (7) electric log NO
(yes or no)
N/A
(organization running log)
- (8) how well bottom plugged 3WV


description of formations encountered	from	to
<u>fill</u>	<u>0</u>	<u>2</u>
<u>Clay</u>	<u>2</u>	<u>18</u>
<u>Clay</u>	<u>18</u>	<u>44</u>
<u>Clay - silt</u>	<u>44</u>	<u>52</u>
<u>Gravel</u>	<u>52</u>	<u>88</u>
<u>Clay</u>	<u>88</u>	<u>104</u>
<u>Fine sd</u>	<u>104</u>	<u>132</u>
<u>Clay - silt</u>	<u>132</u>	<u>260</u>
<u>Clay - silt</u>	<u>260</u>	<u>294</u>
<u>Clay - silt</u>	<u>294</u>	<u>386</u>
<u>sd</u>	<u>386</u>	<u>412</u>
<u>Clay - silt</u>	<u>412</u>	<u>505</u>
<u>Coarse sd</u>	<u>505</u>	<u>546</u>

DRILLERS REMARKS: N/A

RECEIVED
NOV 20 1985

If well telescopes please sketch and show depths.

GROUND LEVEL

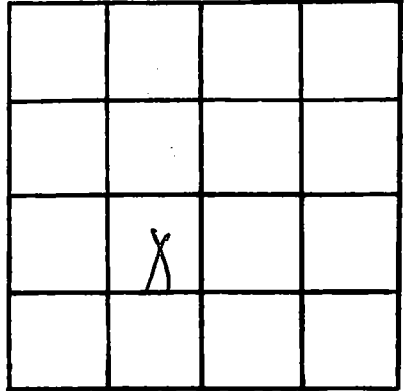

SECTION 37

Please indicate well location X.

ADDITIONAL INFORMATION

If more than one screen,
show locations of each on sketch.