

MISSISSIPPI DEPARTMENT OF NATURAL RESOURCES

Bureau of Land and Water Resources

Southport Mall

P.O. Box 10631

Jackson, Mississippi 39209

WATER WELL DRILLERS LOG

Nov. 6 1985  
date well completed

Wood Well Drilling  
firm name

Harrison  
county well located

LANDOWNER: Adelle Crowley  
Henderson Point  
Pass Christian, ms.  
(mailing address)

description of formations encountered	from	to
	Fill	0
Clay	0	45
Coarse sd	45	68
Clay-Silt	68	478
Med. sd	478	518

WELL LOCATION:  
sec. 27 T. 8 N. R. 13 E. 4  
1/2 miles W of Pass Christian  
(distance) (direction) (nearest town)

WELL PURPOSE: None  
(home, irrigation, municipal, industrial)

- WELL COMPLETION DATA:
- (1) diameter (inches) 2"
  - (2) total depth (feet) 518'
  - (3) static water level (feet) 2 <sup>below</sup> ~~above~~ top of ground
  - (4) casing PVC 498.  
(material) (depth)  
- if telescope see back.  
(size)
  - (5) screen 20' -  
(length) (depth to top)  
2" PVC  
(size) (material)
  - (6) pump 1/2 10  
(HP) (yield gpm)  
Elec.  
(type power)
  - (7) electric log no.  
(yes or no)  
N/A  
(organization running log)
  - (8) how well bottom plugged BWI


DRILLERS REMARKS: N/A

RECEIVED  
DEC 16 1985

Department of Natural Resources  
Bureau of Land & Water Resources

If well telescopes please sketch and show depths.

GROUND LEVEL

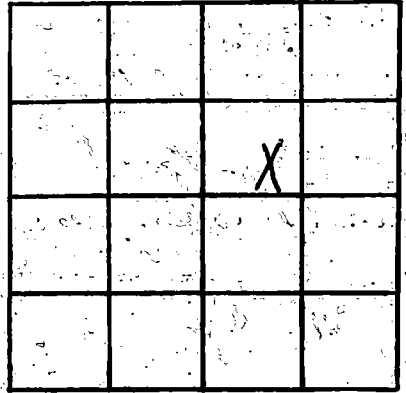

SECTION \_\_\_\_\_

Please indicate well location X.

ADDITIONAL INFORMATION

If more than one screen, show locations of each on sketch.