

MISSISSIPPI DEPARTMENT OF NATURAL RESOURCES

Bureau of Land and Water Resources

Southport Mall

P.O. Box 10631

Jackson, Mississippi 39209

WATER WELL DRILLERS LOG

HANCOCK  
K 2622

Nov. 7 1985 Ward Well Dlg Hancock  
date well completed firm name county well located

LANDOWNER: Duncan Lamb  
Rt. 4, Box 618  
Bay St. Louis, ms.  
(mailing address)

description of formations encountered	from	to
	<u>Clay</u>	<u>0</u>
<u>Clay s.s.</u>	<u>15</u>	<u>45</u>
<u>Clay shell</u>	<u>45</u>	<u>51</u>
<u>Clay</u>	<u>51</u>	<u>86</u>
<u>Coarse ss - fine gravel</u>	<u>86</u>	<u>112</u>

WELL LOCATION:  
sec 26 T 8 N R 13 E 14  
2 miles N/W of B.S.L.  
(distance) (direction) (nearest town)

WELL PURPOSE: Heat Pump  
(home, irrigation, municipal, industrial)

WELL COMPLETION DATA:

- (1) diameter (inches) 4
- (2) total depth (feet) 112
- (3) static water level (feet) 6 ~~below~~ above top of ground.
- (4) casing PVC, 105,  
(material) (depth)  
         If telescope see back.  
(size)
- (5) screen 10',           
(length) (depth to top)  
2", PVC  
(size) (material)
- (6) pump owner,           
(HP) (yield gpm)  
          
(type power)
- (7) electric log NO  
(yes or no)  
N/A  
(organization running log)
- (8) how well bottom plugged BWU


DRILLERS REMARKS: Heating & Cooling only.

**RECEIVED**  
DEC 16 1985

Department of Natural Resources  
Bureau of Land & Water Resources

If well telescopes please sketch and show depths.

GROUND LEVEL

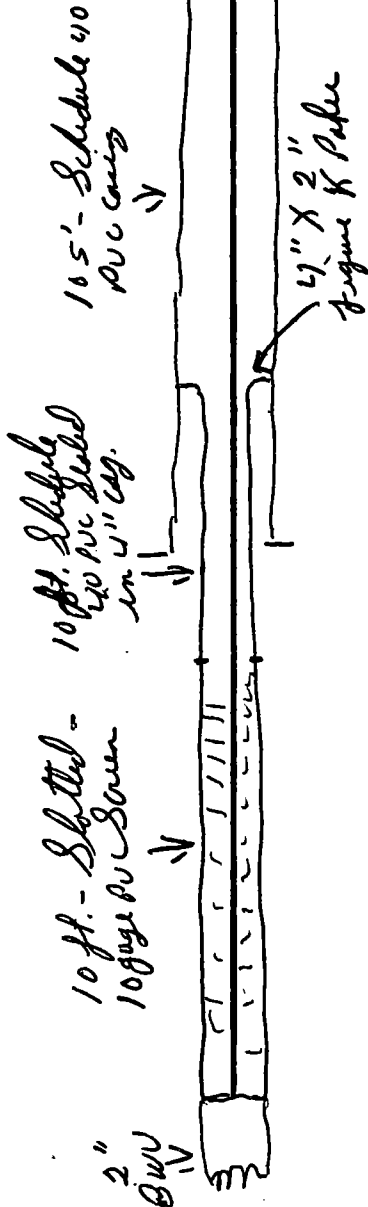

	X		

SECTION 26

Please indicate well location X.

ADDITIONAL INFORMATION

If more than one screen, show locations of each on sketch.