

MISSISSIPPI DEPARTMENT OF NATURAL RESOURCES

Bureau of Land and Water Resources

Southport Mall

P.O. Box 10631

Jackson, Mississippi 39209

WATER WELL DRILLERS LOG

Hancock  
K2624

11-14 1986 Broden Pump Wells Hancock  
date well completed Danny Forehand firm name county well located

LANDOWNER: Danny Forehand

Rt 2 Box 11C - Natchez, Ms.  
(Bay St. Louis, Miss.) 39654  
(mailing address)

WELL LOCATION:  
sec. 40 T. 8 S. R. 14 W.  
2 miles N of Warehead  
(distance) (direction) (nearest town)

WELL PURPOSE: Home  
(home, irrigation, municipal, industrial)

WELL COMPLETION DATA:

- (1) diameter (inches) 2"
- (2) total depth (feet) 262
- (3) static water level (feet) 4 below above top of ground.
- (4) casing PVC 248  
(material) (depth)
- 2" if telescope see back.  
(size)
- (5) screen 10 248  
(length) (depth to top)
- 2" PVC 10085/108  
(size) (material)
- (6) pump 1/2 10  
(HP) (yield gpm)
- 115V 1Ø  
(type power)
- (7) electric log No  
(yes or no)

(organization running log)  
PVC Seal Shark  
(8) how well bottom plugged

description of formations encountered	from	to
Surface	0	6
Clay	6	14
White Sand & Gravel	14	60
White Clay	60	90
Blue Clay	90	162
Sand	162	168
Blue Clay	168	248
Grey Sand	248	258
Blue Clay	258	262+


**RECEIVED**  
APR - 7 1986

Department of Natural Resources  
Bureau of Land & Water Resources

DRILLERS REMARKS:  
4 1/2" Tailpipe.

If well telescopes please sketch and show depths.

GROUND LEVEL

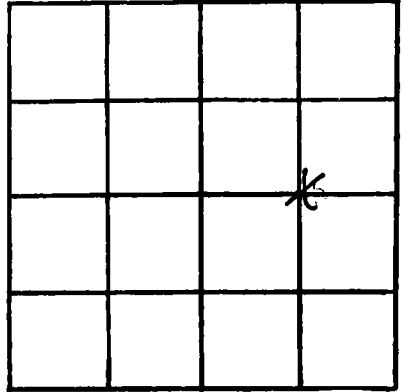

SECTION 40

Please indicate well location X.

ADDITIONAL INFORMATION

If more than one screen, show locations of each on sketch.