

MISSISSIPPI DEPARTMENT OF NATURAL RESOURCES

Bureau of Land and Water Resources

Southport Mall

P.O. Box 10631

Jackson, Mississippi 39209

WATER WELL DRILLERS LOG

HANCOCK  
R 2625

Nov. 14 1985 Wood Well Dlg Hancock  
date well completed firm name county well located

LANDOWNER: Harry Carver  
Rt. 4, Box 587 H  
Bay St. Louis, Ms.  
(mailing address)

WELL LOCATION:  
sec. 35 T 8 N R 13 E 14  
3/4 miles N/W of B.S.L.  
(distance) (direction) (nearest town)

WELL PURPOSE: None  
(home, irrigation, municipal, industrial)

- WELL COMPLETION DATA:
- (1) diameter (inches) 2"
  - (2) total depth (feet) 166
  - (3) static water level (feet) 10 <sup>below</sup> above top of ground.
  - (4) casing PVC, 156  
(material) (depth)  
- if telescope see back.  
(size)
  - (5) screen 10', -  
(length) (depth to top)  
2", PVC  
(size) (material)
  - (6) pump none, -  
(HP) (yield gpm)  
- (type power)
  - (7) electric log NO  
(yes or no)  
N/A  
(organization running log)
  - (8) how well bottom plugged SWJ

description of formations encountered	depth	
	from	to
<u>fill</u>	<u>0</u>	<u>2</u>
<u>clay</u>	<u>2</u>	<u>16</u>
<u>sd</u>	<u>16</u>	<u>47</u>
<u>clay</u>	<u>47</u>	<u>96</u>
<u>sd</u>	<u>96</u>	<u>127</u>
<u>clay</u>	<u>127</u>	<u>148</u>
<u>sd - Red sand</u>	<u>148</u>	<u>166</u>


DRILLERS REMARKS: N/A

**RECEIVED**  
DEC 16 1985

Department of Natural Resources  
Bureau of Land & Water Resources

If well telescopes please sketch and show depths.

GROUND LEVEL

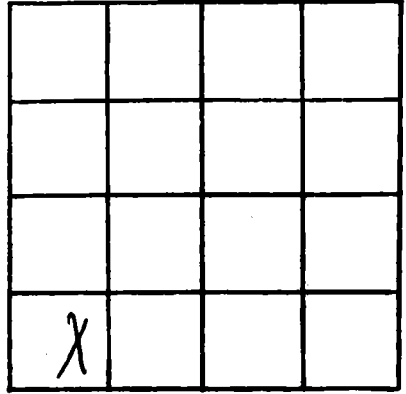

SECTION 35

Please indicate well location X.

ADDITIONAL INFORMATION

If more than one screen, show locations of each on sketch.