

MISSISSIPPI DEPARTMENT OF NATURAL RESOURCES

Bureau of Land and Water Resources

Southport Mall

P.O. Box 10631

Jackson, Mississippi 39209

WATER WELL DRILLERS LOG

HANCOCK  
K 2626

Nov. 19 1985 Ward Well Dr. Hancock  
date well completed firm name county well located

LANDOWNER: Henry Palacio  
Hancock Dr.  
Bay St. Louis, ms.  
(mailing address)

description of formations encountered	from	to
<u>Sandy Soil</u>	<u>0</u>	<u>3</u>
<u>Clay</u>	<u>3</u>	<u>15</u>
<u>SD</u>	<u>15</u>	<u>52</u>
<u>Clay</u>	<u>52</u>	<u>98</u>
<u>SD</u>	<u>98</u>	<u>130</u>
<u>Clay</u>	<u>130</u>	<u>152</u>
<u>Clay - Sand Shunt</u>	<u>152</u>	<u>176</u>
<u>Clay - Silt</u>	<u>176</u>	<u>245</u>
<u>Coar SD</u>	<u>245</u>	<u>273</u>

WELL LOCATION:  
sec. 6 T 9 N R. 14 E  
7 miles W of Wardland  
(distance) (direction) (nearest town)

WELL PURPOSE: Home  
(home, irrigation, municipal, industrial)

- WELL COMPLETION DATA:
- (1) diameter (inches) 2"
  - (2) total depth (feet) 273
  - (3) static water level (feet) 10 <sup>below</sup> above top of ground.
  - (4) casing PVC, 263,  
(material) (depth)  
- If telescope see back.  
(size)
  - (5) screen 10', -  
(length) (depth to top)  
2", PVC  
(size) (material)
  - (6) pump 1/2, 10  
(HP) (yield gpm)  
Elec.  
(type power)
  - (7) electric log NO  
(yes or no)  
N/A  
(organization running log)
  - (8) how well bottom plugged BWV


RECEIVED  
DEC 16 1985

DRILLERS REMARKS: N/A

Department of Natural Resources  
Bureau of Land and Water Resources

If well telescopes please sketch and show depths.

GROUND LEVEL

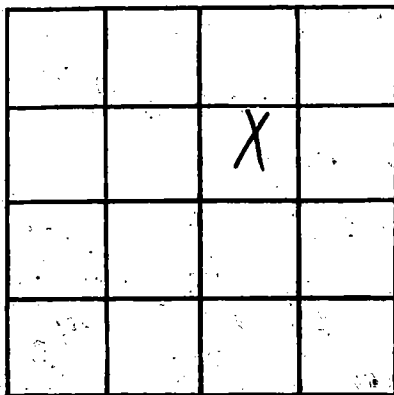

SECTION b

Please indicate well location X.

ADDITIONAL INFORMATION

If more than one screen, show locations of each on sketch.