

MISSISSIPPI DEPARTMENT OF NATURAL RESOURCES

Bureau of Land and Water Resources

Southport Mall

P.O. Box 10631

Jackson, Mississippi 39209

WATER WELL DRILLERS LOG

Nov. 26
date well completed

1985 Ward Well Drg.
firm name

Hancock
county well located

LANDOWNER: Cliff A Moon
Rt. 2, Box 485 H
Bay St. Louis, ms
(mailing address)

description of formations encountered

from to

WELL LOCATION:
sec 3 T 9 N R 14 E
1/2 miles W of B.S.L.
(distance) (direction) (nearest town)

| | | |
|-----------------|-----|-----|
| Clay | 0 | 16 |
| Sd | 16 | 46 |
| Clay | 46 | 95 |
| Sd | 95 | 100 |
| Clay | 100 | 146 |
| Sd - Red Gravel | 146 | 168 |

WELL PURPOSE: Dom
(home, irrigation, municipal, industrial)

- WELL COMPLETION DATA:
- (1) diameter (inches) 2"
 - (2) total depth (feet) 168
 - (3) static water level (feet) 11 below above top of ground.
 - (4) casing PVC, 158,
(material) (depth)
 - (size) If telescope see back.
 - (5) screen 10', -
(length) (depth to top)
 - 2", PVC
(size) (material)
 - (6) pump Dom, -
(HP) (yield gpm)
 - (type power)
 - (7) electric log NO
(yes or no)
 - BWA
(organization running log)
 - (8) how well bottom plugged BWV


RECEIVED
DEC 16 1985

DRILLERS REMARKS: N/A

Department of Natural Resources
Bureau of Land & Water Resources

If well telescopes please sketch and show depths.

GROUND LEVEL

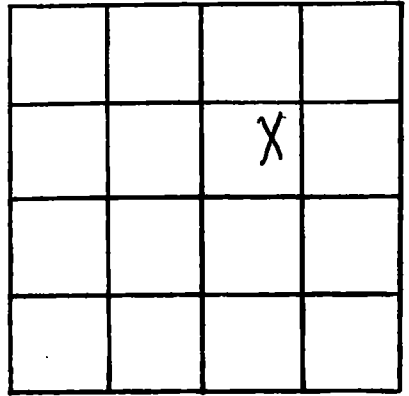

SECTION 3

Please indicate well location X.

ADDITIONAL INFORMATION

If more than one screen,
show locations of each on sketch.