

MISSISSIPPI DEPARTMENT OF NATURAL RESOURCES

Bureau of Land and Water Resources

Southport Mall

P.O. Box 10631

Jackson, Mississippi 39209

WATER WELL DRILLERS LOG

12-4
date well completed

1985 Ward Well Dr. firm name

Hancock county well located

LANDOWNER: Charles E. Fenell
P.O. Box 453
Bay St. Louis, Ms.
(mailing address)

WELL LOCATION:
sec. 29 T. 8 N. R. 14 E. T. 3
6 miles N/W of Warland
(distance) (direction) (nearest town)

WELL PURPOSE: Home
(home, irrigation, municipal, industrial)

- WELL COMPLETION DATA:
- (1) diameter (inches) 2"
 - (2) total depth (feet) 220
 - (3) static water level (feet) 4 below top of ground.
 - (4) casing PVC 210 (material) (depth)
 - (size) If telescope see back.
 - (5) screen 10' (length) (depth to top)
 - 2" PVC (size) (material)
 - (6) pump owner (HP) (yield gpm)
 - (type power)
 - (7) electric log no (yes or no)
 - (organization running log) N/A
 - (8) how well bottom plugged BWV

description of formations encountered	from	to
clay	0	18
clay sd	18	47
clay	47	85
sd	85	96
clay	96	108
thin bedded sd	108	115
clay-silt	115	185
coral sd	185	220


RECEIVED
JAN 17 1985

Department of Natural Resources
Bureau of Land & Water Resources

DRILLERS REMARKS: N/A

If well telescopes please sketch and show depths.

GROUND LEVEL

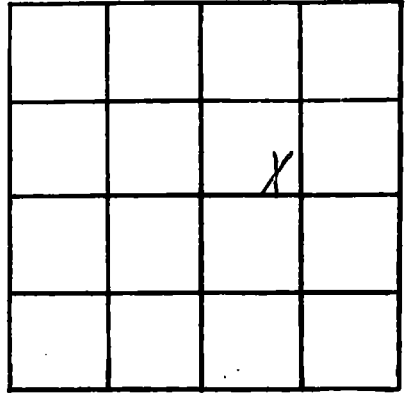

SECTION 29

Please indicate well location X.

ADDITIONAL INFORMATION

If more than one screen,
show locations of each on sketch.