

MISSISSIPPI DEPARTMENT OF NATURAL RESOURCES

Bureau of Land and Water Resources

Southport Mall

P.O. Box 10631

Jackson, Mississippi 39209

WATER WELL DRILLERS LOG

Hancock  
K 2631

12-11-

19

85 Ward Well Dr.

Hancock

date well completed

firm name

county well located

LANDOWNER:

Andie Arceneaux  
Rt. 7, Box 199

description of formations encountered

from

to

Bay St. Louis, Mrs.  
(mailing address)

fill-clay  
sd  
clay  
Coast sd-limestone

0	12
12	45
45	96
96	122

WELL LOCATION:

sec. 6 T. 9 N R. 14 E  
5 miles SW of Waveland  
(distance) (direction) (nearest town)

WELL PURPOSE:

Home  
(home, irrigation, municipal, industrial)

WELL COMPLETION DATA:

(1) diameter (inches) 2"  
(2) total depth (feet) 122'  
(3) static water level (feet) 12 below above top of ground.

(4) casing PVC 112'  
(material) (depth)  
(size) If telescope see back.


(5) screen 10' -  
(length) (depth to top)  
2" PVC  
(size) (material)

(6) pump Ornel -  
(HP) (yield gpm)  
(type power)

(7) electric log NO  
(yes or no)  
N/A  
(organization running log)

(8) how well bottom plugged BWU

DRILLERS REMARKS: N/A

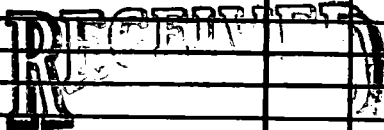


JAN 17 1966

Department of Natural Resources  
Bureau of Land and Water Resources

If well telescopes please sketch and show depths.

GROUND LEVEL

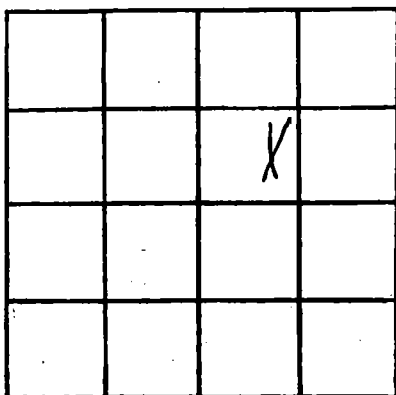

SECTION 6

Please indicate well location X.

ADDITIONAL INFORMATION

If more than one screen, show locations of each on sketch.