

MISSISSIPPI DEPARTMENT OF NATURAL RESOURCES

Bureau of Land and Water Resources

Southport Mall

P.O. Box 10631

Jackson, Mississippi 39209

WATER WELL DRILLERS LOG

Hancock
K2633

Feb. 24 1986 Ward Well Dr Hancock
date well completed firm name county well located

LANDOWNER Louis Cabrise
Lark St.
Box St. Louis Mrs.
(mailing address)

description of formations as encountered	depth	
	from	to
<u>Fill - Clay</u>	<u>0</u>	<u>21</u>
<u>sd</u>	<u>21</u>	<u>42</u>
<u>Clay - silt</u>	<u>42</u>	<u>94</u>
<u>Red Gravel - sd</u>	<u>94</u>	<u>105</u>
<u>Clay - silt</u>	<u>105</u>	<u>190</u>
<u>Med. coarse sd</u>	<u>190</u>	<u>230</u>

WELL LOCATION:
sec. 29 T. 8 N. R. 14 E
6 miles N/W of Wardland
(distance) (direction) (nearest town)

WELL PURPOSE: Home
(home, irrigation, municipal, industrial)

WELL COMPLETION DATA:

(1) diameter (inches) 2"

(2) total depth (feet) 230

(3) static water level (feet) 1 below above top of ground

(4) casing PVC 220
(material) (depth)

- (size) If telescope see back.

(5) screen 10' -
(length) (depth to top)

2" PVC
(size) (material)

(6) pump none -
(HP) (yield gpm)


- (type power)

(7) electric log no -
(yes or no)

N/A
(organization running log)

(8) how well bottom plugged BW


DRILLERS REMARKS: N/A

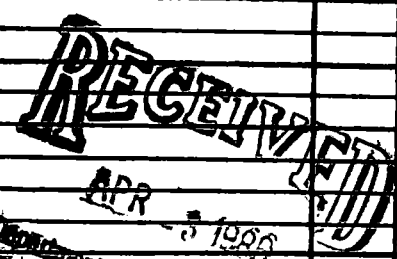

Department of Natu.
Bureau of Land & Water Resources

If well telescopes please sketch and show depths.

GROUND LEVEL

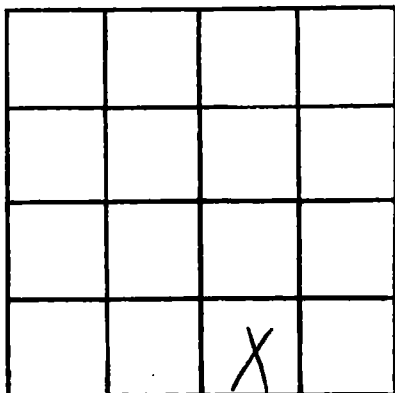

SECTION 29

Please indicate well location X.

ADDITIONAL INFORMATION

If more than one screen, show locations of each on sketch.