

MISSISSIPPI DEPARTMENT OF NATURAL RESOURCES

Bureau of Land and Water Resources

Southport Mall

P.O. Box 10631

Jackson, Mississippi 39209

WATER WELL DRILLERS LOG

Hancock
R 2634

March 26 1986 St Ward Well Dg. Hancock
date well completed firm name county well located


LANDOWNER	description of formations encountered	from	to
<u>Joseph E. Inero</u>	<u>clay</u>	<u>0</u>	<u>14</u>
<u>Missouri St.</u>	<u>2 sd</u>	<u>14</u>	<u>47</u>
<u>Bay St. Louis mo.</u>	<u>clay - silt</u>	<u>47</u>	<u>102</u>
(mailing address)	<u>sd</u>	<u>102</u>	<u>120</u>

WELL LOCATION:
sec. 40 T. 8 N R. 14 E
4 miles N/W of Waveland
(distance) (direction) (nearest town)

WELL PURPOSE: Home
(home, irrigation, municipal, industrial)

- WELL COMPLETION DATA:
- (1) diameter (inches) 2"
 - (2) total depth (feet) 120'
 - (3) static water level (feet) 5 below above top of ground.
 - (4) casing PVC 110
(material) (depth)
— if telescope see back.
(size)
 - (5) screen 10' —
(length) (depth to top)
2" PVC
(size) (material)
 - (6) pump owner —
(HP) (yield gpm)
—
(type power)
 - (7) electric log NO
(yes or no)
N/A
(organization running log)
 - (8) how well bottom plugged BWU

DRILLERS REMARKS: N/A

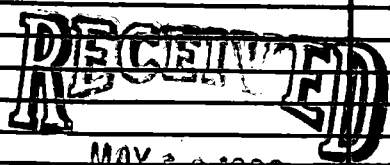


MAY 12 1986

Department of Natural Resources
Bureau of Land and Water Resources

If well telescopes please sketch and show depths.

GROUND LEVEL

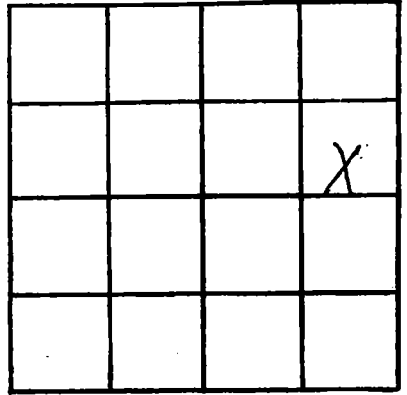

SECTION 40

Please indicate well location X.

ADDITIONAL INFORMATION

If more than one screen,
show locations of each on sketch.