

MISSISSIPPI DEPARTMENT OF NATURAL RESOURCES

Bureau of Land and Water Resources

Southport Mall

P.O. Box 10631

Jackson, Mississippi 39209

WATER WELL DRILLERS LOG

HANCOCK
K 2635

3-27-86 19
date well completed

R Moore
firm name

Hancock
county well located

LANDOWNER: PHI FORD
Ford CONCRETE
Colspan MS
(mailing address)

description of formations encountered	from	to
<u>TOP SOIL</u>	<u>0</u>	<u>10</u>
<u>Pvc Sand</u>	<u>10</u>	<u>160</u>
<u>Blue clay</u>	<u>160</u>	<u>150</u>
<u>Coarse Sand</u>	<u>150</u>	<u>210</u>

WELL LOCATION:
sec. 19 T. 8 N. R. 14 E.
2 miles S of 1-10
(distance) (direction) (nearest town)

WELL PURPOSE: CEMENT MCH
(home, irrigation, municipal, industrial)

WELL COMPLETION DATA:

(1) diameter (inches) 4'

(2) total depth (feet) 210'

(3) static water level (feet) 0 below above top of ground. TOP of Sand

(4) casing Pvc, 210'
(material) (depth)
4" if telescope see back.
(size)

(5) screen 20', 210'
(length) (depth to top)
4", Pvc
(size) (material)

(6) pump 5, 125
(HP) (yield gpm)
E
(type power)

(7) electric log _____
(yes or no)

(organization running log)

(8) how well bottom plugged Partial

RECEIVED


APR 21 1986

Department of Natural Resources
Bureau of Land & Water Resources

DRILLERS REMARKS: _____

If well telescopes please sketch and show depths.

GROUND LEVEL

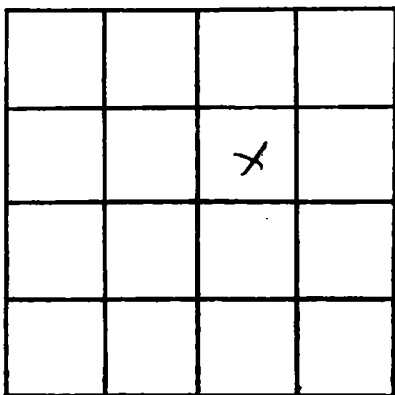

SECTION X

Please indicate well location X.

ADDITIONAL INFORMATION

If more than one screen, show locations of each on sketch.