

Hancock
K2636

MISSISSIPPI DEPARTMENT OF NATURAL RESOURCES
Bureau of Land and Water Resources
Southport Mall
P.O. Box 10631
Jackson, Mississippi 39209
WATER WELL DRILLERS LOG

March 27 19 86 Wood Well Dr. Hancock
date well completed firm name county well located

LANDOWNER Larry Graft
Arkansas St.
Bay St. Louis, Ms.
(mailing address)

description of formations encountered	from	to
<u>fill - clay</u>	<u>0</u>	<u>15</u>
<u>sd</u>	<u>15</u>	<u>44</u>
<u>clay</u>	<u>44</u>	<u>105</u>
<u>fine sd</u>	<u>105</u>	<u>112</u>
<u>clay - shell</u>	<u>112</u>	<u>174</u>
<u>sd</u>	<u>174</u>	<u>190</u>

WELL LOCATION:
sec. 40 T. 8 N. R. 14 E.
4 miles N of Waveland
(distance) (direction) (nearest town)

WELL PURPOSE: Home
(home, irrigation, municipal, industrial)

- WELL COMPLETION DATA:
- (1) diameter (inches) 2"
 - (2) total depth (feet) 190'
 - (3) static water level (feet) 7 below top of ground.
 - (4) casing PVC, 180,
(material) (depth)
— if telescope see back.
(size)
 - (5) screen 10, —
(length) (depth to top)
2", PVC
(size) (material)
 - (6) pump —, —
(HP) (yield gpm)
— (type power)
 - (7) electric log NO
(yes or no)
N/A
(organization running log)
 - (8) how well bottom plugged BWW


DRILLERS REMARKS: N/A

RECEIVED
MAY 19 1986

Department of Natural Resources
Bureau of Land & Water Resources

If well telescopes please sketch and show depths.

GROUND LEVEL

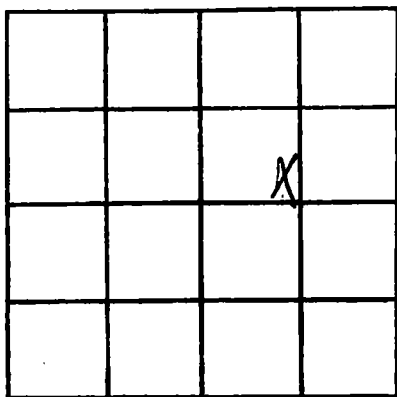

SECTION 410

Please indicate well location X.

ADDITIONAL INFORMATION

If more than one screen, show locations of each on sketch.