

MISSISSIPPI DEPARTMENT OF NATURAL RESOURCES

Bureau of Land and Water Resources

Southport Mall

P.O. Box 10631

Jackson, Mississippi 39209

WATER WELL DRILLERS LOG

Hancock
K2637

March 28
date well completed

1986 Ward Well Drg.
firm name

Hancock
county well located

LANDOWNER: Sirita Keating
Rt. 2, Box 342 F
Bay St. Louis, Ms.
(mailing address)

WELL LOCATION:
sec. 8 T. 9 N. R. 14 E
5 miles S/W of Waveland
(distance) (direction) (nearest town)

WELL PURPOSE: Home
(home, irrigation, municipal, industrial)

WELL COMPLETION DATA:

(1) diameter (inches) 2"

(2) total depth (feet) 315

(3) static water level (feet) 12 ^{below} above top of ground.

(4) casing PVC 305
(material) (depth)
- If telescope see back.
(size)

(5) screen 10' -
(length) (depth to top)
2" PVC
(size) (material)

(6) pump 1/2 10
(HP) (yield gpm)
Elec.
(type power)

(7) electric log no
(yes or no)
N/A
(organization running log)

(8) how well bottom plugged BWU

description of formations encountered	from	to
<u>Fill - clay</u>	<u>0</u>	<u>12</u>
<u>sd</u>	<u>12</u>	<u>46</u>
<u>clay</u>	<u>46</u>	<u>95</u>
<u>Red shales - sd</u>	<u>95</u>	<u>115</u>
<u>clay - silt</u>	<u>115</u>	<u>208</u>
<u>fine sd</u>	<u>208</u>	<u>222</u>
<u>clay - silt</u>	<u>222</u>	<u>275</u>
<u>coarse sd</u>	<u>275</u>	<u>315</u>

DRILLERS REMARKS: N/A


RECEIVED

MAY 1 1986

Department of Natural Resources
Bureau of Land & Water Resources

If well telescopes please sketch and show depths.

GROUND LEVEL

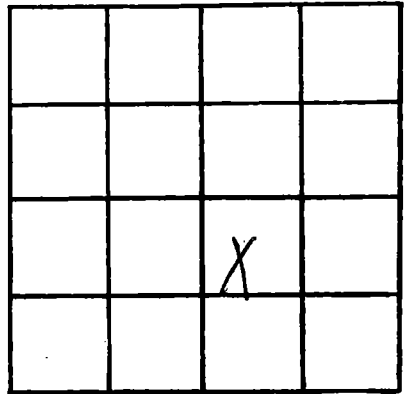

SECTION 8

Please indicate well location X.

ADDITIONAL INFORMATION

A series of 18 horizontal lines for entering additional information.

If more than one screen, show locations of each on sketch.