

MISSISSIPPI DEPARTMENT OF NATURAL RESOURCES

Bureau of Land and Water Resources

Southport Mall

P.O. Box 10631

Jackson, Mississippi 39209

WATER WELL DRILLERS LOG

HANCOCK
K 2638

March 31 1986 Ward Well Dlg Hancock
date well completed firm name county well located

LANDOWNER: Ethel Loop
Lakeshore Rd
Lakeshore, ms.
(mailing address)

description of formations encountered	from	to
Top Soil - clay	0	10
SC	10	48
clay	48	106
Red Gravelly SD	106	121
clay - silt	121	212
fine SD	212	226
clay - silt	226	274
Coar SD	274	315

WELL LOCATION:
sec. 18 T-9 N R-14 E
14 miles S/W of B.S.L.
(distance) (direction) (nearest town)

WELL PURPOSE: Home
(home, irrigation, municipal, industrial)

- WELL COMPLETION DATA:
- (1) diameter (inches) 2"
 - (2) total depth (feet) 315
 - (3) static water level (feet) 12 below top of ground
 - (4) casing PVC 305 (material), (depth)
 - (size) If telescope see back.
 - (5) screen 10 (length), (depth to top)
 - 2" (size), PVC (material)
 - (6) pump owner (HP), (yield gpm)
 - (type power)
 - (7) electric log NO (yes or no)
 - (organization running log) N/A
 - (8) how well bottom plugged BWW


RECEIVED
MAY 19 1986

DRILLERS REMARKS: N/A

Department of Natural Resources
Bureau of Land & Water Resources

If well telescopes please sketch and show depths.

GROUND LEVEL

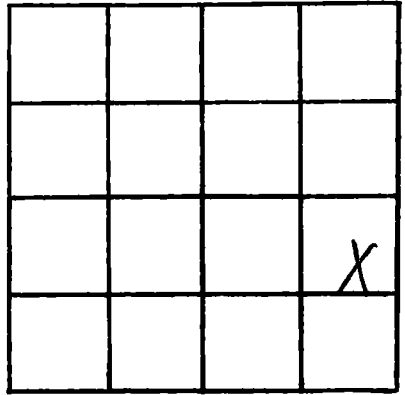

SECTION 18

Please indicate well location X.

ADDITIONAL INFORMATION

If more than one screen, show locations of each on sketch.