

MISSISSIPPI DEPARTMENT OF NATURAL RESOURCES

Bureau of Land and Water Resources

Southport Mall

P.O. Box 10631

Jackson, Mississippi 39209

WATER WELL DRILLERS LOG

Hancock  
K 2639

April 14 1986 Ward Well Dr. Hancock  
date well completed firm name county well located

LANDOWNER: Lee Redford  
Rt. 6, Box 606K  
Bay St. Louis, ms.  
(mailing address)

WELL LOCATION:  
sec. 40 T. 8 N R. 14 E  
5 miles NW of B.S.L.  
(distance) (direction) (nearest town)

WELL PURPOSE: None  
(home, irrigation, municipal, industrial)

- WELL COMPLETION DATA:
- (1) diameter (inches) 2"
  - (2) total depth (feet) 176
  - (3) static water level (feet) 6 <sup>below</sup> top of ground
  - (4) casing 166 (material) - (depth)  
- (size) If telescope see back.
  - (5) screen 10' (length) - (depth to top)  
2" (size) PVC (material)
  - (6) pump owner (HP) - (yield gpm)  
- (type power)
  - (7) electric log NO (yes or no)  
KJA (organization running log)
  - (8) how well bottom plugged BWU


description of formations encountered	from	to
<u>fill - clay</u>	<u>0</u>	<u>18</u>
<u>sd</u>	<u>18</u>	<u>47</u>
<u>gray</u>	<u>47</u>	<u>105</u>
<u>fine sd</u>	<u>105</u>	<u>112</u>
<u>clay - silt</u>	<u>112</u>	<u>155</u>
<u>med sd</u>	<u>155</u>	<u>176</u>

**RECEIVED**  
MAY 19 1986

DRILLERS REMARKS: NJA

If well telescopes please sketch and show depths.

GROUND LEVEL

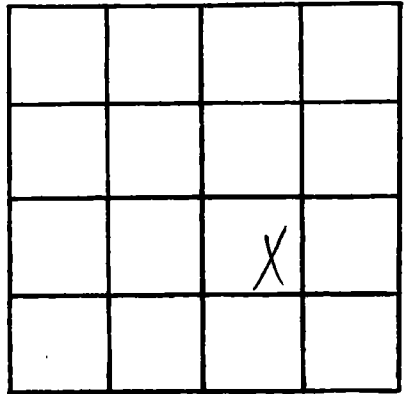

SECTION 40

Please indicate well location X.

ADDITIONAL INFORMATION

If more than one screen, show locations of each on sketch.