

MISSISSIPPI DEPARTMENT OF NATURAL RESOURCES

Bureau of Land and Water Resources

Southport Mall

P.O. Box 10631

Jackson, Mississippi 39209

WATER WELL DRILLERS LOG

Hancock
K2640

April 22 1986 Ward Well by Hancock
date well completed firm name county well located

LANDOWNER: Bertold Stemann
Rt. 2 Box 351 JY
Bay St. Louis ms.
(mailing address)

WELL LOCATION:
37 sec. 9 T. 9 N. R. 10 E.
14 miles SW of B.S.L.
(distance) (direction) (nearest town)

WELL PURPOSE: None
(home, irrigation, municipal, industrial)

- WELL COMPLETION DATA:
- (1) diameter (inches) 4" X 2"
 - (2) total depth (feet) 315
 - (3) static water level (feet) 8 ^{below} above top of ground.
 - (4) casing PVC, 295,
(material) (depth)
(size) if telescope see back.
 - (5) screen 20', -
(length) (depth to top)
2", PVC
(size) (material)
 - (6) pump 1/2 sub, 25
(HP) (yield gpm)
Elec.
(type power)
 - (7) electric log NO
(yes or no)
N/A
(organization running log)
 - (8) how well bottom plugged BWU

description of formations encountered	from	to
<u>Fill - clay</u>	<u>0</u>	<u>10</u>
<u>sd</u>	<u>10</u>	<u>13</u>
<u>clay</u>	<u>13</u>	<u>17</u>
<u>sd</u>	<u>17</u>	<u>48</u>
<u>clay w/ shell</u>	<u>48</u>	<u>95</u>
<u>Red shales - sd</u>	<u>95</u>	<u>126</u>
<u>clay - silt</u>	<u>126</u>	<u>190</u>
<u>st. fine ss</u>	<u>190</u>	<u>216</u>
<u>clay - silt</u>	<u>216</u>	<u>275</u>
<u>Red shales - sd</u>	<u>275</u>	<u>315</u>

RECEIVED


JUN 06 1986

Department of Natural Resources
Bureau of Land & Water Resources

DRILLERS REMARKS: N/A

If well telescopes please sketch and show depths.

GROUND LEVEL

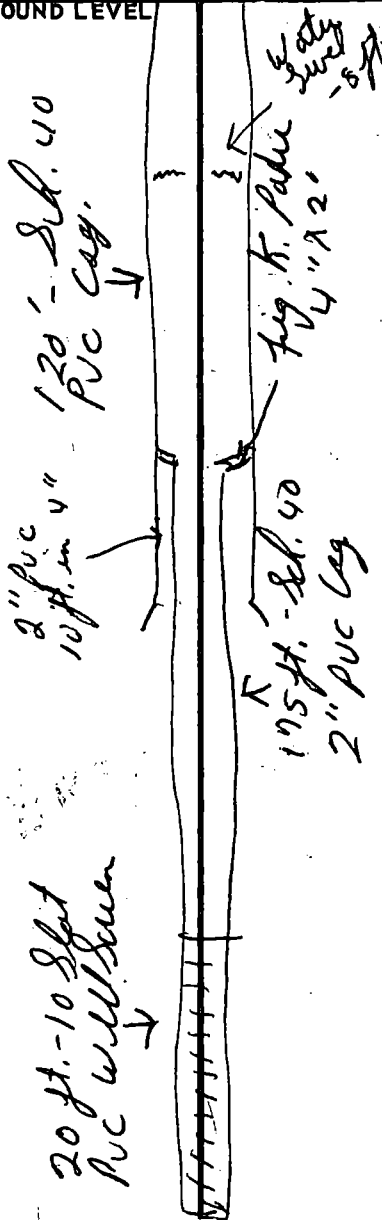

			X

SECTION 13

Please indicate well location X.

ADDITIONAL INFORMATION

If more than one screen, show locations of each on sketch.