

MISSISSIPPI DEPARTMENT OF NATURAL RESOURCES

Bureau of Land and Water Resources

Southport Mall

P.O. Box 10631

Jackson, Mississippi 39209

WATER WELL DRILLERS LOG

HANCOCK
K2641

May 15 1986 Ward Well Dr. Hancock
date well completed firm name county well located

LANDOWNER: George Patterson
River View Estates
Bay St. Lamin Mo.
(mailing address)

description of formations encountered	from	to
<u>Fill - clay</u>	<u>0</u>	<u>15</u>
<u>sd</u>	<u>15</u>	<u>47</u>
<u>clay</u>	<u>47</u>	<u>105</u>
<u>fine sd</u>	<u>105</u>	<u>118</u>
<u>clay - silt</u>	<u>118</u>	<u>152</u>
<u>medium sd.</u>	<u>152</u>	<u>168</u>

WELL LOCATION:
sec. 39 T. 9 N. R. 14 E.
9 miles N/W of B.S.L.
(distance) (direction) (nearest town)

WELL PURPOSE: camp
(home, irrigation, municipal, industrial)

- WELL COMPLETION DATA:
- (1) diameter (inches) 2"
 - (2) total depth (feet) 168
 - (3) static water level (feet) 6 below above top of ground.
 - (4) casing PVC, 158
(material) (depth)
- if telescope see back.
(size)
 - (5) screen 10', -
(length) (depth to top)
2", PVC
(size) (material)
 - (6) pump owner, -
(HP) (yield gpm)
NO
(type power)
 - (7) electric log no
(yes or no)
N/A
(organization running log)
 - (8) how well bottom plugged BWU

RECEIVED


JUN 27 1986

Department of Natural Resources
Bureau of Land & Water Resources

DRILLERS REMARKS: N/A

If well telescopes please sketch and show depths.

GROUND LEVEL

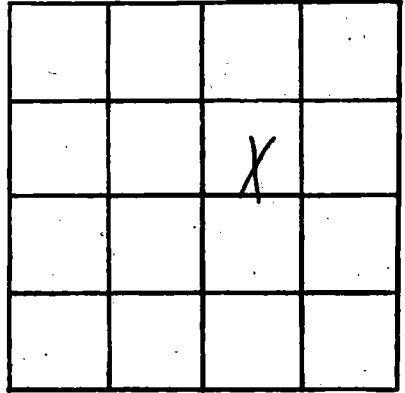

SECTION 39

Please indicate well location X.

ADDITIONAL INFORMATION

If more than one screen, show locations of each on sketch.