

NAUCCOCK
K2645

MISSISSIPPI DEPARTMENT OF NATURAL RESOURCES
Bureau of Land and Water Resources
Southport Mall
P.O. Box 10631
Jackson, Mississippi 39209
WATER WELL DRILLERS LOG

May 22 1986 Ward Well Drg Natchez
date well completed firm name county well located

LANDOWNER Sola Hess
Park & Desoto Drive
Bay St. Louis, ms.
(mailing address)

description of formations encountered	from	to
Clay	0	12
Clay	12	42
Clay	42	95
Coarse sd	95	128
Clay - Silt	128	147
Red Shale - S	147	160

WELL LOCATION:
sec. 6 T. 9 N. R. 14 E
6 miles W of Ward
(distance) (direction) (nearest town)

WELL PURPOSE: Home
(home, irrigation, municipal, industrial)

- WELL COMPLETION DATA:
- (1) diameter (inches) 2"
 - (2) total depth (feet) 160
 - (3) static water level (feet) 12 ^(below) above top of ground.
 - (4) casing PVC, 150,
(material) (depth)
 if telescope see back.
(size)
 - (5) screen 10',
(length) (depth to top)
2", PVC
(size) (material)
 - (6) pump owner -
(HP) (yield gpm)

(type power)
 - (7) electric log NO
(yes or no)
N/A
(organization running log)
 - (8) how well bottom plugged BWU


RECEIVED
JUN 27 1986

Department of Natural Resources
Bureau of Land & Water Resources

DRILLERS REMARKS: N/A

If well telescopes please sketch and show depths.

GROUND LEVEL

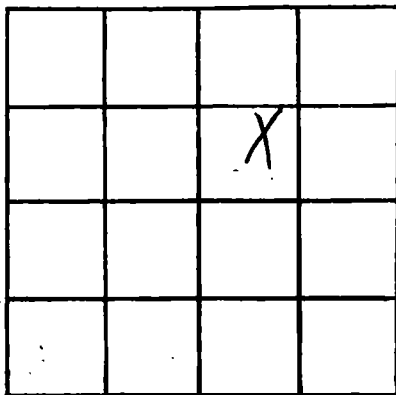

SECTION 6

Please indicate well location X.

ADDITIONAL INFORMATION

If more than one screen, show locations of each on sketch.