

MISSISSIPPI DEPARTMENT OF NATURAL RESOURCES

Bureau of Land and Water Resources

Southport Mall

P.O. Box 10631

Jackson, Mississippi 39209

WATER WELL DRILLERS LOG

Hancock  
K2647

May 27 1986 Ward Well Drg. Hancock  
date well completed firm name county well located

LANDOWNER: Winnie Wilson  
Hancock Drive  
Bay St. Louis ms.  
(mailing address)


WELL LOCATION:  
sec. 6 T 9 N R 14 E  
6 miles W of Waveland  
(distance) (direction) (nearest town)

WELL PURPOSE: Home  
(home, irrigation, municipal, industrial)

WELL COMPLETION DATA:

- (1) diameter (inches) 2"
- (2) total depth (feet) 312
- (3) static water level (feet) 12 <sup>below</sup> top of ground
- (4) casing PVC 302  
(material) (depth)  
(size) If telescope see back.
- (5) screen 10' -  
(length) (depth to top)  
2"  
(size) (material)
- (6) pump owner -  
(HP) (yield gpm)  
(type power)
- (7) electric log no  
(yes or no)  
N/A  
(organization running log)
- (8) how well bottom plugged BWD

description of formations encountered	from	to
<u>Fill - clay</u>	<u>0</u>	<u>15</u>
<u>sd</u>	<u>15</u>	<u>46</u>
<u>clay</u>	<u>46</u>	<u>105</u>
<u>Coar. sd</u>	<u>105</u>	<u>128</u>
<u>clay-silt</u>	<u>128</u>	<u>152</u>
<u>Red sh. sand &amp; sd</u>	<u>152</u>	<u>176</u>
<u>clay-silt</u>	<u>176</u>	<u>275</u>
<u>Coar. sd</u>	<u>275</u>	<u>312</u>

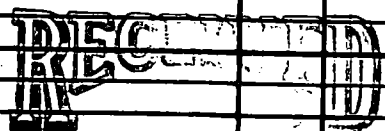


JUN 27 1986

Department of Natural Resources  
Bureau of Land & Water Resources

DRILLERS REMARKS: N/A

If well telescopes please sketch and show depths.

GROUND LEVEL

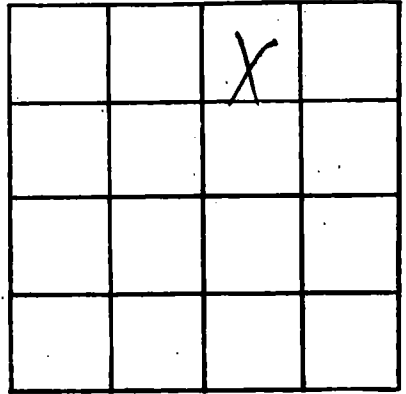

SECTION 6

Please indicate well location X.

ADDITIONAL INFORMATION

If more than one screen, show locations of each on sketch.