

MISSISSIPPI DEPARTMENT OF NATURAL RESOURCES

Bureau of Land and Water Resources

Southport Mall

P.O. Box 10631

Jackson, Mississippi 39209

WATER WELL DRILLERS LOG

Hancock
K 2649

May 29 1986 Wood Well Drg. Hancock
date well completed firm name county well located

LANDOWNER: Sauron W. Stourd
Junia St.
Bay St. Louis mo.
(mailing address)

WELL LOCATION:
sec. 6 T-9 N R-14 E
7 miles W of Waverly
(distance) (direction) (nearest town)

WELL PURPOSE: Home
(home, irrigation, municipal, industrial)

WELL COMPLETION DATA:

(1) diameter (inches) 2"

(2) total depth (feet) 294

(3) static water level (feet) 12 ^{below} above top of ground

(4) casing PVC 284
(material) (depth)

- If telescope see back.
(size)

(5) screen 10 -
(length) (depth to top)

2" PVC
(size) (material)

(6) pump none -
(HP) (yield gpm)


-
(type power)

(7) electric log NO
(yes or no)

N/A
(organization running log)

(8) how well bottom plugged BWD

description of formations encountered	from	to
	<u>Clay</u>	<u>0</u>
<u>sd</u>	<u>12</u>	<u>42</u>
<u>Clay</u>	<u>42</u>	<u>94</u>
<u>sd</u>	<u>94</u>	<u>128</u>
<u>Clay</u>	<u>128</u>	<u>152</u>
<u>Red gravel - sd</u>	<u>152</u>	<u>176</u>
<u>Clay - silt</u>	<u>176</u>	<u>268</u>
<u>sd</u>	<u>268</u>	<u>294</u>

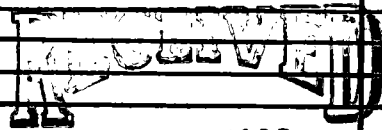

AUG 4 1986

Department of Natural Resources
Bureau of Land & Water Resources

DRILLERS REMARKS: N/A

If well telescopes please sketch and show depths.

GROUND LEVEL

		X	

SECTION 6

Please indicate well location X.

ADDITIONAL INFORMATION

If more than one screen, show locations of each on sketch.