

MISSISSIPPI DEPARTMENT OF NATURAL RESOURCES

Bureau of Land and Water Resources

Southport Mall

P.O. Box 10631

Jackson, Mississippi 39209

WATER WELL DRILLERS LOG

Hancock
K2651

June 5 1986 Wood Well Dly Hancock
date well completed firm name county well located

LANDOWNER: Billy Bryant
Full St.
Waveland ms.
(mailing address)

description of fomations encountered	from	to
<u>Clay</u>	<u>0</u>	<u>16</u>
<u>sd</u>	<u>16</u>	<u>35</u>
<u>Clay</u>	<u>35</u>	<u>84</u>
<u>sd</u>	<u>84</u>	<u>90</u>
<u>Clay - Silt</u>	<u>90</u>	<u>176</u>
<u>Ria Shovel - sd</u>	<u>176</u>	<u>190</u>

WELL LOCATION:
sec. 3 T. 8 N. R. 14 E. W
miles _____ of Waveland
(distance) (direction) (nearest town)

WELL PURPOSE: Irrigation
(home, Irrigation, municipal, Industrial)

- WELL COMPLETION DATA:
- (1) diameter (inches) 2"
 - (2) total depth (feet) 190'
 - (3) static water level (feet) 13 ^{below} _{above} top of ground.
 - (4) casing PVC, 180,
(material) (depth)

(size) If telescope see back.
 - (5) screen 10', _____
(length) (depth to top)
2", PVC
(size) (material)
 - (6) pump owner
(HP) (yield gpm)

(type power)
 - (7) electric log NO
(yes or no)
N/A
(organization running log)
 - (8) how well bottom plugged BWA

RECEIVED


AUG 4 1986

Department of Natural Resources
Bureau of Land & Water Resources

DRILLERS REMARKS: N/A

If well telescopes please sketch and show depths.

GROUND LEVEL

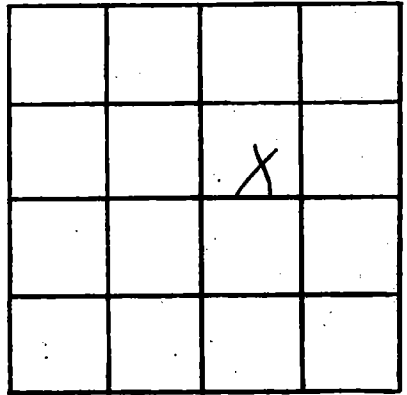

SECTION 3

Please indicate well location X.

ADDITIONAL INFORMATION

If more than one screen,
show locations of each on sketch.