

MISSISSIPPI DEPARTMENT OF NATURAL RESOURCES

Bureau of Land and Water Resources

Southport Mall

P.O. Box 10631

Jackson, Mississippi 39209

WATER WELL DRILLERS LOG

HANCOCK  
K0652

July 2 1986 Ward Well Dlg. Hancock  
date well completed firm name county well located

LANDOWNER Ray Brewster  
Ave. D  
Bay St. Louis, ms.  
(mailing address)

WELL LOCATION:  
sec. 28 T. 8 N. R. 14 E.  
3 miles N/W of Waveland  
(distance) (direction) (nearest town)

WELL PURPOSE: Home  
(home, irrigation, municipal, industrial)

WELL COMPLETION DATA:

(1) diameter (inches) 2"

(2) total depth (feet) 184

(3) static water level (feet) 4 below top of ground.

(4) casing PVC 174  
(material) (depth)  
- If telescope see back.  
(size)

(5) screen 10' -  
(length) (depth to top)  
2" PVC  
(size) (material)

(6) pump owner -  
(HP) (yield gpm)  
-  
(type power)

(7) electric log NO  
(yes or no)  
N/A  
(organization running log)

(8) how well bottom plugged BWU


description of formations encountered	from	to
<u>fill - clay</u>	<u>0</u>	<u>16</u>
<u>sd</u>	<u>16</u>	<u>47</u>
<u>clay</u>	<u>47</u>	<u>76</u>
<u>sd</u>	<u>76</u>	<u>85</u>
<u>clay - silt</u>	<u>85</u>	<u>104</u>
<u>fine sd</u>	<u>104</u>	<u>116</u>
<u>clay - silt</u>	<u>116</u>	<u>162</u>
<u>med. sd</u>	<u>162</u>	<u>184</u>

**RECEIVED**  
AUG 21 1986  
Department of Natural Resources  
Bureau of Land & Water Resources

DRILLERS REMARKS: N/A

If well telescopes please sketch and show depths.

GROUND LEVEL

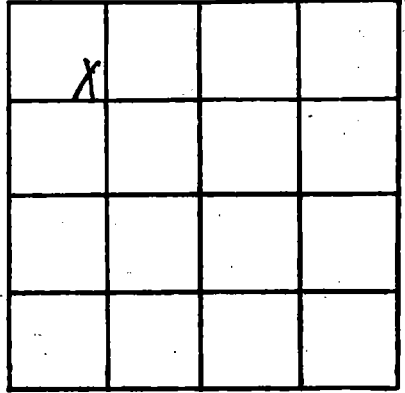

SECTION 28

Please indicate well location X.

ADDITIONAL INFORMATION

If more than one screen,  
show locations of each on sketch.