

MISSISSIPPI DEPARTMENT OF NATURAL RESOURCES

Bureau of Land and Water Resources

Southport Mall

P.O. Box 10631

Jackson, Mississippi 39209

WATER WELL DRILLERS LOG

HAWCOCK
K 2653


July 2 1986 Ward Well Drg. Hancock
date well completed firm name county well located

LANDOWNER: George Bach
Sayhill St.
Bay St. Louis ms.
(mailing address)

description of formations encountered	from	to
<u>fill - clay</u>	<u>0</u>	<u>14</u>
<u>clay sd</u>	<u>14</u>	<u>32</u>
<u>sd - hard shell</u>	<u>32</u>	<u>45</u>
<u>crs sd - shell</u>	<u>45</u>	<u>90</u>
	<u>90</u>	<u>120</u>

WELL LOCATION:
sec 19 T 8 N R 14 E
6 miles N/W of Wardland
(distance) (direction) (nearest town)

WELL PURPOSE: Home
(home, irrigation, municipal, industrial)

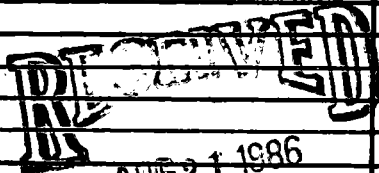


- WELL COMPLETION DATA:
- (1) diameter (inches) 2"
 - (2) total depth (feet) 120
 - (3) static water level (feet) 6 ^{below} top of ground
 - (4) casing PVC, 110,
(material) (depth)
 If telescope see back.
(size)
 - (5) screen 10' -
(length) (depth to top)
2" PVC
(size) (material)
 - (6) pump none -
(HP) (yield gpm)
 (type power)
 - (7) electric log NO
(yes or no)
N/A
(organization running log)
 - (8) how well bottom plugged BWU

Department of Natural Resources
Bureau of Land & Water Resources

DRILLERS REMARKS: N/A

If well telescopes please sketch and show depths.

GROUND LEVEL

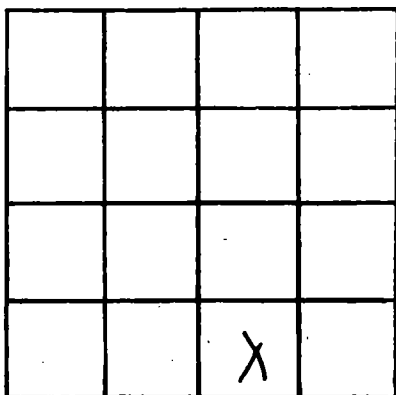

SECTION 19

Please indicate well location X.

ADDITIONAL INFORMATION

If more than one screen,
show locations of each on sketch.