

MISSISSIPPI DEPARTMENT OF NATURAL RESOURCES

Bureau of Land and Water Resources

Southport Mall

P.O. Box 10631

Jackson, Mississippi 39209

WATER WELL DRILLERS LOG

Hancock  
K 2655

July 8 1986 Ward Well Dr. Hancock  
date well completed firm name county well located

LANDOWNER: Elmer maish  
ave. D & 5th St.  
Bay St. Louis mo.  
(mailing address)

WELL LOCATION:  
sec. 28 T. 8 N. R. 14 E.  
3 miles n/w of Waubesa  
(distance) (direction) (nearest town)

WELL PURPOSE: Home  
(home, irrigation, municipal, industrial)

WELL COMPLETION DATA:

(1) diameter (inches) 2"

(2) total depth (feet) 180

(3) static water level (feet) 6 <sup>caly</sup> above top of ground.

(4) casing PVC 170  
(material) (depth)  
- If telescope see back.  
(size)

(5) screen 10' -  
(length) (depth to top)  
2" PVC  
(size) (material)

(6) pump Own -  
(HP) (yield gpm)  
-  
(type power)

(7) electric log NO  
(yes or no)  
N/A  
(organization running log)

(8) how well bottom plugged OWU

description of formations encountered	from	to
<u>Sandy Soil</u>	<u>0</u>	<u>2</u>
<u>Clay</u>	<u>2</u>	<u>18</u>
<u>sd</u>	<u>18</u>	<u>49</u>
<u>Clay</u>	<u>49</u>	<u>75</u>
<u>Clay silt</u>	<u>75</u>	<u>86</u>
<u>Clay silt</u>	<u>86</u>	<u>105</u>
<u>Clay silt</u>	<u>105</u>	<u>116</u>
<u>med. sd</u>	<u>116</u>	<u>160</u>
	<u>160</u>	<u>180</u>


**RECEIVED**  
AUG 21 1986

Department of Natural Resources  
Bureau of Land & Water Resources

DRILLERS REMARKS: N/A

If well telescopes please sketch and show depths.

GROUND LEVEL

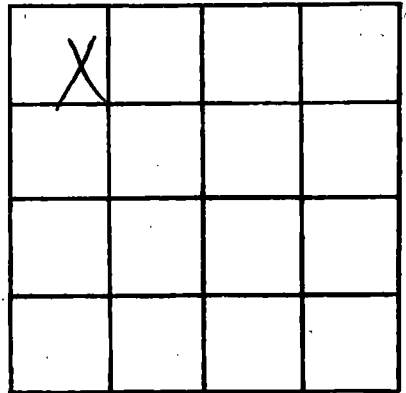

SECTION 28

Please indicate well location X.

ADDITIONAL INFORMATION

If more than one screen,  
show locations of each on sketch.