

MISSISSIPPI DEPARTMENT OF NATURAL RESOURCES

Bureau of Land and Water Resources

Southport Mall

P.O. Box 10631

Jackson, Mississippi 39209

WATER WELL DRILLERS LOG

Hancock  
K 2656

July 17 1986 Wood Well Dr. Hancock  
date well completed firm name county well located


LANDOWNER: Mr. D. Carpenter  
Deal St.  
Boy St. Louis mo  
(mailing address)

description of formations encountered	from	to
<u>clay</u>	<u>0</u>	<u>18</u>
<u>clay sd</u>	<u>18</u>	<u>48</u>
<u>clay</u>	<u>48</u>	<u>54</u>
<u>Coarct sd</u>	<u>54</u>	<u>100</u>

WELL LOCATION:  
sec. 28 T 8 N R. 14 E  
4 miles N/W of Wardland  
(distance) (direction) (nearest town)

WELL PURPOSE: Home  
(home, irrigation, municipal, industrial)


- WELL COMPLETION DATA:
- (1) diameter (inches) 2"
  - (2) total depth (feet) 147
  - (3) static water level (feet) 6 below top of ground.
  - (4) casing PVC 137  
(material) (depth)
  - (size) If telescope see back.
  - (5) screen 10' -  
(length) (depth to top)
  - 2" PVC  
(size) (material)
  - (6) pump over -  
(HP) (yield gpm)
  - (type power)
  - (7) electric log no  
(yes or no)
  - N/A  
(organization running log)
  - (8) how well bottom plugged BW 0

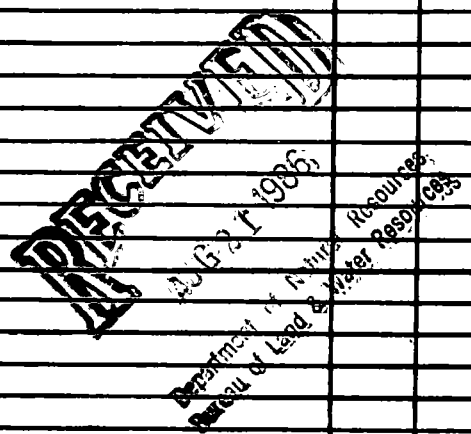

DRILLERS REMARKS: N/A

If well telescopes please sketch and show depths.

GROUND LEVEL

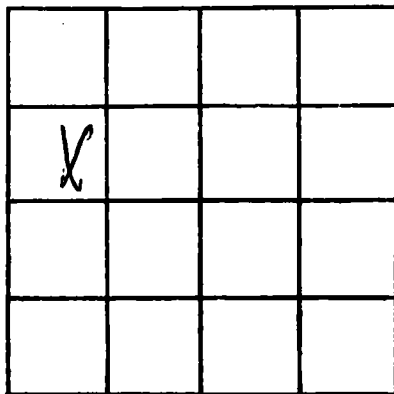

SECTION 28

Please indicate well location X.

ADDITIONAL INFORMATION

If more than one screen,  
show locations of each on sketch.