

MISSISSIPPI DEPARTMENT OF NATURAL RESOURCES

Bureau of Land and Water Resources

Southport Mall

P.O. Box 10631

Jackson, Mississippi 39209

WATER WELL DRILLERS LOG

Hancock  
K2657

July 21 1986 Ward Well Dr. Hancock  
date well completed firm name county well located


LANDOWNER: Fred Moore  
Forest St.  
Clairmont/Harbor, ms.  
(mailing address)

WELL LOCATION:  
sec. 17 T. 9 N. R. 14 E.  
6 miles S/W of Woodland  
(distance) (direction) (nearest town)

WELL PURPOSE: None  
(home, irrigation, municipal, industrial)

- WELL COMPLETION DATA:
- (1) diameter (inches) 2"
  - (2) total depth (feet) 334
  - (3) static water level (feet) 8 below above top of ground.
  - (4) casing PVC 324  
(material) (depth)
  - (size) if telescope see back.
  - (5) screen 10' -  
(length) (depth to top)  
2" PVC  
(size) (material)
  - (6) pump none -  
(HP) (yield gpm)  
(type power)
  - (7) electric log NO  
(yes or no)  
N/A  
(organization running log)
  - (8) how well bottom plugged BWV

description of formations encountered	from	to
<u>Fill</u>	<u>0</u>	<u>2</u>
<u>Clay</u>	<u>2</u>	<u>18</u>
<u>SS</u>	<u>18</u>	<u>52</u>
<u>Clay-shell</u>	<u>52</u>	<u>95</u>
<u>Red Shell - SS</u>	<u>95</u>	<u>128</u>
<u>Clay-shell</u>	<u>128</u>	<u>210</u>
<u>Shale SS</u>	<u>210</u>	<u>226</u>
<u>Clay-shell</u>	<u>226</u>	<u>285</u>
<u>Red Shell - coarse SS</u>	<u>286</u>	<u>334</u>

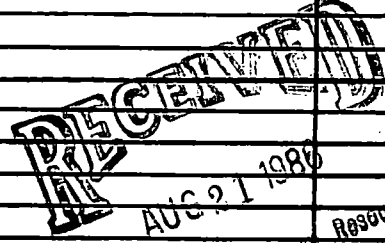


Department of Natural Resources  
Bureau of Land & Water Resources

DRILLERS REMARKS: N/A

If well telescopes please sketch and show depths.

GROUND LEVEL

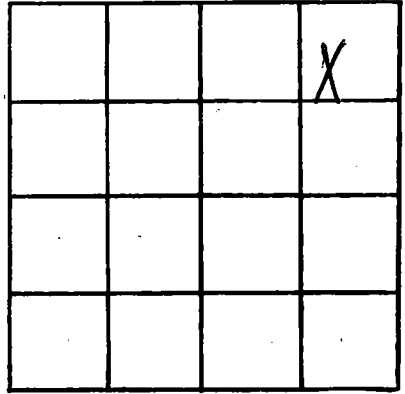

SECTION 17

Please indicate well location X.

ADDITIONAL INFORMATION

If more than one screen,  
show locations of each on sketch.