

MISSISSIPPI DEPARTMENT OF NATURAL RESOURCES
Bureau of Land and Water Resources
 Southport Mall
 P.O. Box 10631
 Jackson, Mississippi 39209
WATER WELL DRILLERS LOG

Hancock
K 2658

July 23 1986 Ward Well Drg. Hancock
 date well completed firm name county well located

LANDOWNER: Richard J. Fayard
Hancock Drive
Box St. Louis, Mo.
 (mailing address)

description of formations encountered	from	to
<u>Top Soil - clay</u>	<u>0</u>	<u>12</u>
<u>sd</u>	<u>12</u>	<u>47</u>
<u>clay</u>	<u>47</u>	<u>91</u>
<u>sd</u>	<u>96</u>	<u>132</u>
<u>clay - silt</u>	<u>132</u>	<u>148</u>
<u>Red Shell - sd</u>	<u>148</u>	<u>168</u>

WELL LOCATION:
 sec. 6 T 9 N R 14 E
2 miles S/W of Wareland
 (distance) (direction) (nearest town)

WELL PURPOSE: Home
 (home, irrigation, municipal, industrial)

- WELL COMPLETION DATA:**
- (1) diameter (inches) 2"
 - (2) total depth (feet) 168
 - (3) static water level (feet) 12 ^{below} ~~above~~ top of ground.
 - (4) casing PVC, 158,
 (material) (depth)
— if telescope see back.
 (size)
 - (5) screen 10', —
 (length) (depth to top)
2", PVC
 (size) (material)
 - (6) pump owner, —
 (HP) (yield gpm)
—
 (type power)
 - (7) electric log no
 (yes or no)
N/A
 (organization running log)
 - (8) how well bottom plugged BWV

DRILLERS REMARKS: N/A


RECEIVED

OCT 06 1986

Department of Natural Resources
 Bureau of Land & Water Resources

If well telescopes please sketch and show depths.

GROUND LEVEL

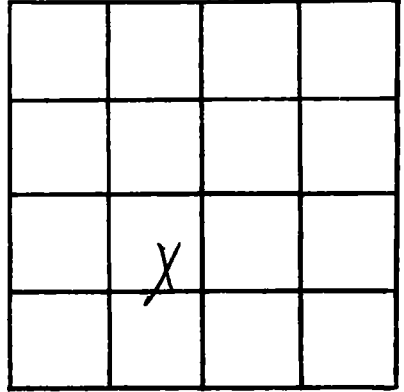

SECTION 6

Please indicate well location X.

ADDITIONAL INFORMATION

If more than one screen,
show locations of each on sketch.