

HANCOCK  
K 2659

MISSISSIPPI DEPARTMENT OF NATURAL RESOURCES  
Bureau of Land and Water Resources  
Southport Mall  
P.O. Box 10631  
Jackson, Mississippi 39209  
**WATER WELL DRILLERS LOG**

Aug. 4 1986 Wood Well Pkg. Hancock  
date well completed firm name county well located

LANDOWNER: Elwood Taylor  
Longfellow Drive  
Waveland, Ms.  
(mailing address)

WELL LOCATION:  
sec. 34 T-8 N R-14 E  
1/2 miles W of B.S.L.  
(distance) (direction) (nearest town)

WELL PURPOSE: irrigation  
(home, irrigation, municipal, industrial)

WELL COMPLETION DATA:

- (1) diameter (inches) 2"
- (2) total depth (feet) 440
- (3) static water level (feet) 12 <sup>below</sup> ~~above~~ top of ground.
- (4) casing PVC 420  
(material) (depth)  
         if telescope see back.  
(size)
- (5) screen 20'           
(length) (depth to top)  
2" PVC  
(size) (material)
- (6) pump owner           
(HP) (yield gpm)  
          
(type power)
- (7) electric log no  
(yes or no)  
N/A  
(organization running log)
- (8) how well bottom plugged BWU

description of formations encountered	from to	
	ft	ft
<u>Dark Soil</u>	<u>0</u>	<u>4</u>
<u>SD Clay</u>	<u>4</u>	<u>18</u>
<u>clay</u>	<u>18</u>	<u>56</u>
<u>clay</u>	<u>56</u>	<u>84</u>
<u>Red gravel - SD</u>	<u>84</u>	<u>126</u>
<u>Clay - Silt</u>	<u>126</u>	<u>190</u>
<u>SD</u>	<u>190</u>	<u>212</u>
<u>clay</u>	<u>212</u>	<u>395</u>
<u>SD</u>	<u>395</u>	<u>440</u>

**RECEIVED**


OCT 06 1986

Department of Natural Resources  
Bureau of Land & Water Resources

DRILLERS REMARKS: N/A

If well telescopes please sketch and show depths.

GROUND LEVEL

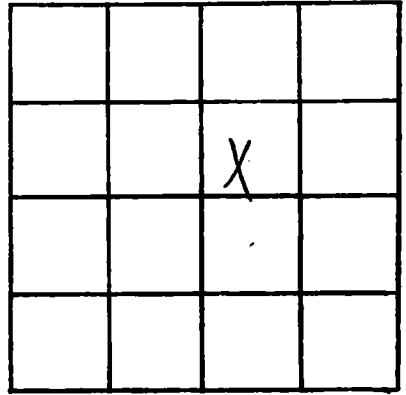

SECTION 34

Please indicate well location X.

ADDITIONAL INFORMATION

If more than one screen, show locations of each on sketch.