

MISSISSIPPI DEPARTMENT OF NATURAL RESOURCES

Bureau of Land and Water Resources

Southport Mall

P.O. Box 10631

Jackson, Mississippi 39209

WATER WELL DRILLERS LOG

Hancock
K 26 Co

Aug. 27 1986 Wood Well Dr Hancock
date well completed firm name county well located

LANDOWNER: Wood Holmer
Skyline Drive
Boy St. Louis mo.
(mailing address)

WELL LOCATION:
sec. 22 T-8 N R-14 E
4 miles N/W of B.S.L.
(distance) (direction) (nearest town)

WELL PURPOSE: none
(home, irrigation, municipal, industrial)

WELL COMPLETION DATA:

(1) diameter (inches) 2"

(2) total depth (feet) 405

(3) static water level (feet) 1 below above top of ground.

(4) casing PVC 395
(material) (depth)

- if telescope see back.
(size)

(5) screen 10' -
(length) (depth to top)

2" PVC
(size) (material)

(6) pump owner -
(HP) (yield gpm)

-
(type power)

(7) electric log NO
(yes or no)

N/A
(organization running log)

(8) how well bottom plugged BWU

description of formations encountered	from	to
<u>fill-clay</u>	<u>0</u>	<u>18</u>
<u>sd</u>	<u>18</u>	<u>47</u>
<u>clay</u>	<u>47</u>	<u>86</u>
<u>fine sd</u>	<u>96</u>	<u>115</u>
<u>clay-silt</u>	<u>115</u>	<u>154</u>
<u>fine sd</u>	<u>154</u>	<u>168</u>
<u>clay-silt</u>	<u>168</u>	<u>380</u>
<u>coke sd</u>	<u>380</u>	<u>405</u>


RECEIVED
OCT 29 1986

Department of Natural Resources
Bureau of Land & Water Resources

DRILLERS REMARKS: N/A

If well telescopes please sketch and show depths.

GROUND LEVEL

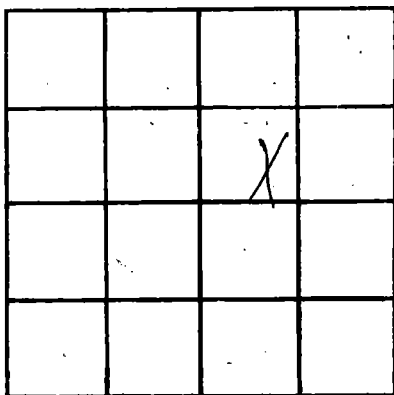

SECTION 22

Please indicate well location X.

ADDITIONAL INFORMATION

If more than one screen,
show locations of each on sketch.