

MISSISSIPPI DEPARTMENT OF NATURAL RESOURCES

Bureau of Land and Water Resources

Southport Mall

P.O. Box 10631

Jackson, Mississippi 39209

WATER WELL DRILLERS LOG

| |
|---------|
| HANCOCK |
| K 2665 |
| |
| |

Sept. 3 1986 date well completed Ward Well Dr. firm name Hancock county well located

LANDOWNER: Nile Borghini
 Honeyuckle Drive
 Bay St. Louis, Mo.
 (mailing address)

| description of formations encountered | from | to |
|---------------------------------------|------|-----|
| fill-clay | 0 | 18 |
| sd | 18 | 54 |
| clay | 54 | 80 |
| sd | 80 | 95 |
| clay-silt | 95 | 106 |
| fine sd | 106 | 150 |
| sd | 150 | 176 |
| clay-silt | 176 | 260 |
| fine sd | 260 | 292 |
| clay-silt | 292 | 385 |
| coarse sd | 385 | 418 |

WELL LOCATION:
 sec. 27 T 8 N R 14 E
 2 1/2 miles N/W of B.S.L.
 (distance) (direction) (nearest town)

WELL PURPOSE: Hand
 (home, irrigation, municipal, industrial)

WELL COMPLETION DATA:

(1) diameter (inches) 2"

(2) total depth (feet) 418

(3) static water level (feet) 1 below above top of ground.

(4) casing PVC 408
 (material) (depth)

 If telescope see back.
 (size)

(5) screen 10'
 (length) (depth to top)

2" PVC
 (size) (material)

(6) pump 1/2 10
 (HP) (yield gpm)

Elec.
 (type power)

(7) electric log NO
 (yes or no)

N/A
 (organization running log)

(8) how well bottom plugged BWJ

RECEIVED


OCT 29 1986

Department of Natural Resources
 Bureau of Land & Water Resources

DRILLERS REMARKS: N/A

If well telescopes please sketch and show depths.

GROUND LEVEL

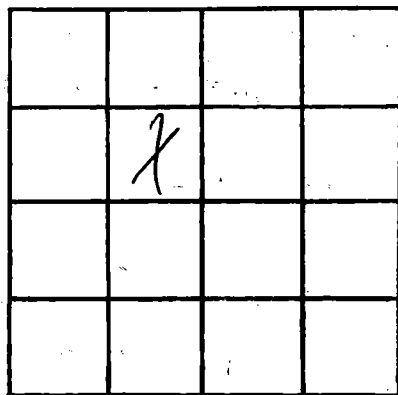

SECTION 27

Please indicate well location X.

ADDITIONAL INFORMATION

If more than one screen,
show locations of each on sketch.