

MISSISSIPPI DEPARTMENT OF NATURAL RESOURCES

Bureau of Land and Water Resources

Southport Mall

P.O. Box 10631

Jackson, Mississippi 39209

WATER WELL DRILLERS LOG

Hancock  
K 2668

Sept. 9 1986 Wood Well Dr. Hancock  
date well completed firm name county well located

LANDOWNER: James Burton  
 Hwy 603  
 Bay St. Louis mnr.  
(mailing address)

description of formations encountered	from	to
<u>clay</u>	<u>0</u>	<u>18</u>
<u>sd</u>	<u>18</u>	<u>52</u>
<u>clay</u>	<u>52</u>	<u>94</u>
<u>fine sd</u>	<u>94</u>	<u>116</u>
<u>clay-silt</u>	<u>116</u>	<u>152</u>
<u>sd</u>	<u>152</u>	<u>168</u>

WELL LOCATION:  
sec. 28 T. 8 N. R. 14 E  
4 miles N of Woodland  
(distance) (direction) (nearest town)

WELL PURPOSE: None  
(home, irrigation, municipal, industrial)

- WELL COMPLETION DATA:
- (1) diameter (inches) 2"
  - (2) total depth (feet) 168
  - (3) static water level (feet) 8 below above top of ground.
  - (4) casing PVC, 158'  
(material) (depth)  
- if telescope see back.  
(size)
  - (5) screen 10', -  
(length) (depth to top)  
2", PVC  
(size) (material)
  - (6) pump owner, -  
(HP) (yield gpm)  
- (type power)
  - (7) electric log no  
(yes or no)  
N/A  
(organization running log)
  - (8) how well bottom plugged BW 2

**RECEIVED**


OCT 29 1986

Department of Natural Resources  
Bureau of Land & Water Resources

DRILLERS REMARKS: N/A

If well telescopes please sketch and show depths.

GROUND LEVEL

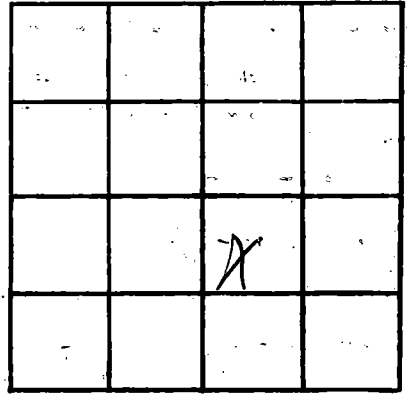

SECTION 28

Please indicate well location X.

ADDITIONAL INFORMATION

If more than one screen, show locations of each on sketch.